




SUITE 275
AS BUILT - 1 OF 1
IRBY BUILDING - LEVEL TWO
4,700 USF / 5,452 RSF
SCALE: 3/32" = 1'-0"
DATE: AUGUST 23, 2018

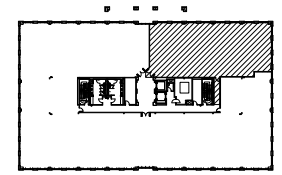

KEY PLAN

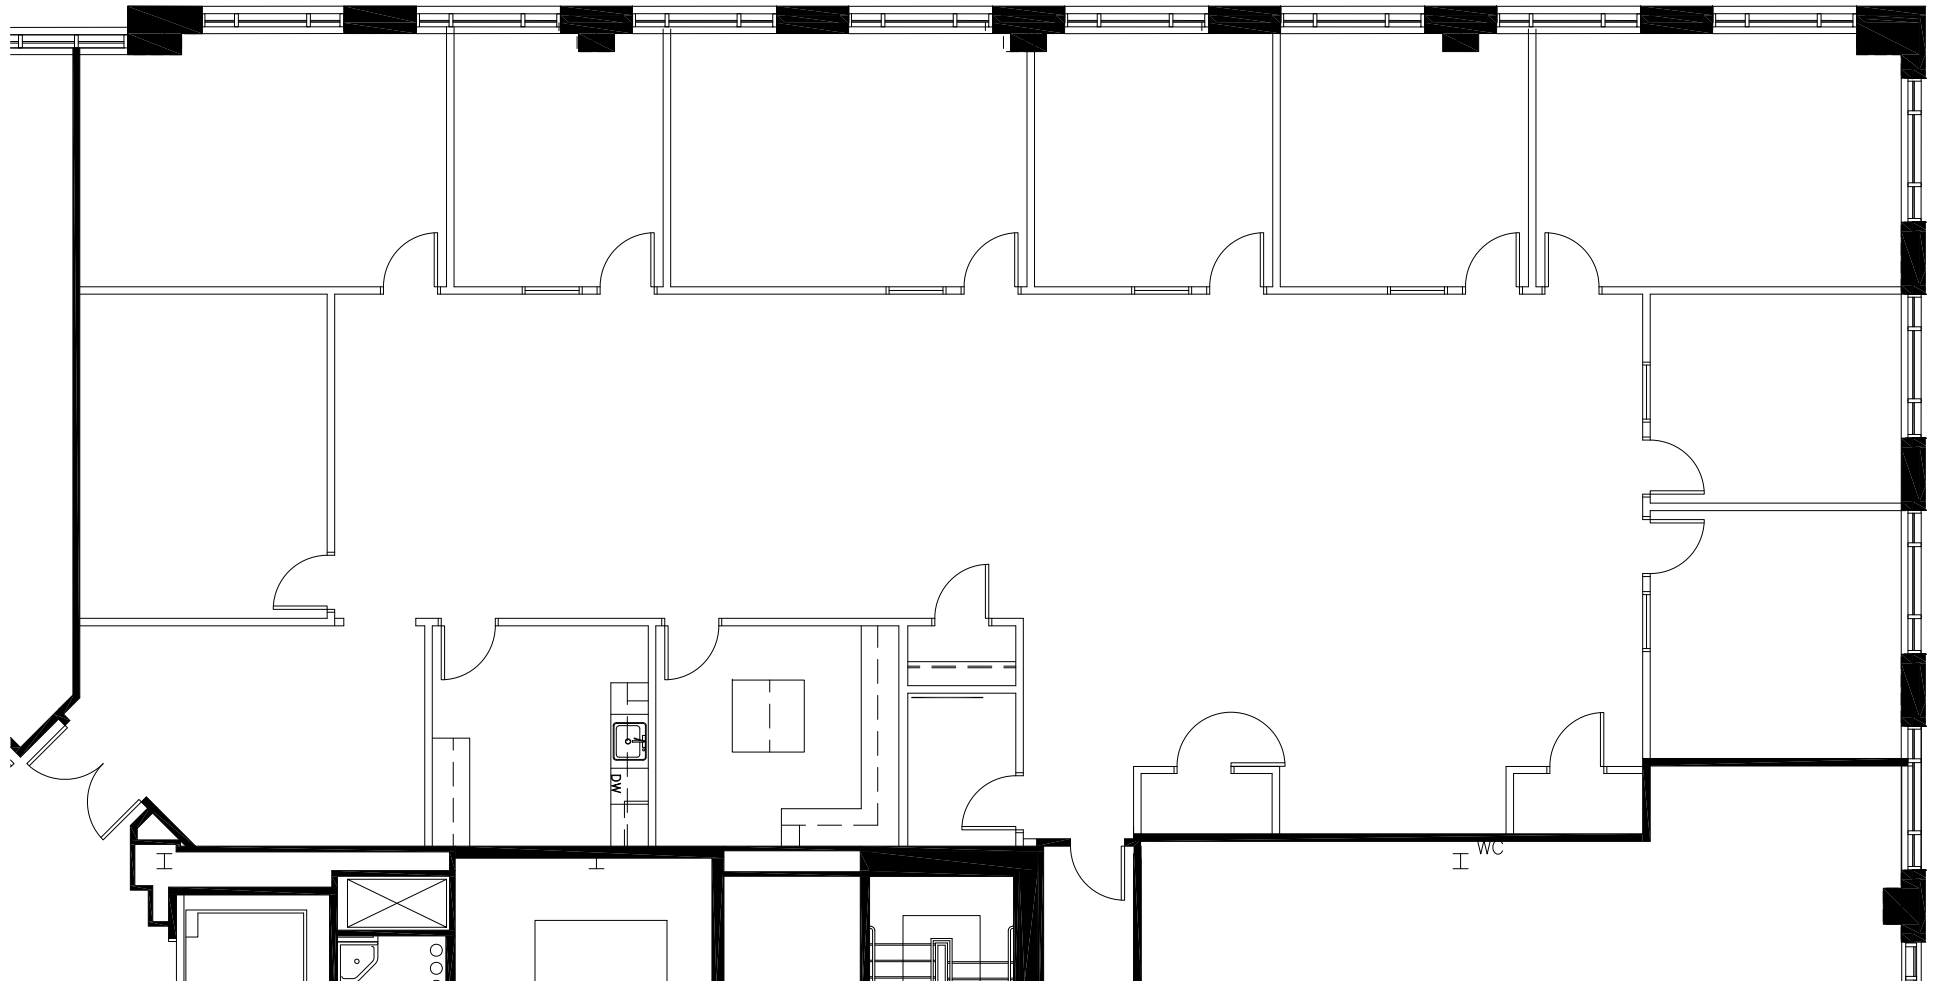

NORTHWOOD
OFFICE

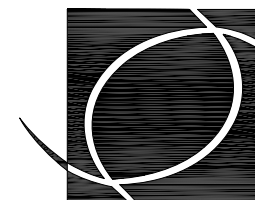

**SMITH
HARRIS
DESIGN**
associates