




SUITE 100
AS-BUILT - 1 OF 1
GIBSON BUILDING - LEVEL ONE
13,418 USF/ 15,431 RSF
NOT TO SCALE
DATE: MAY 1, 2017

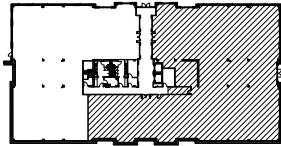

KEY PLAN

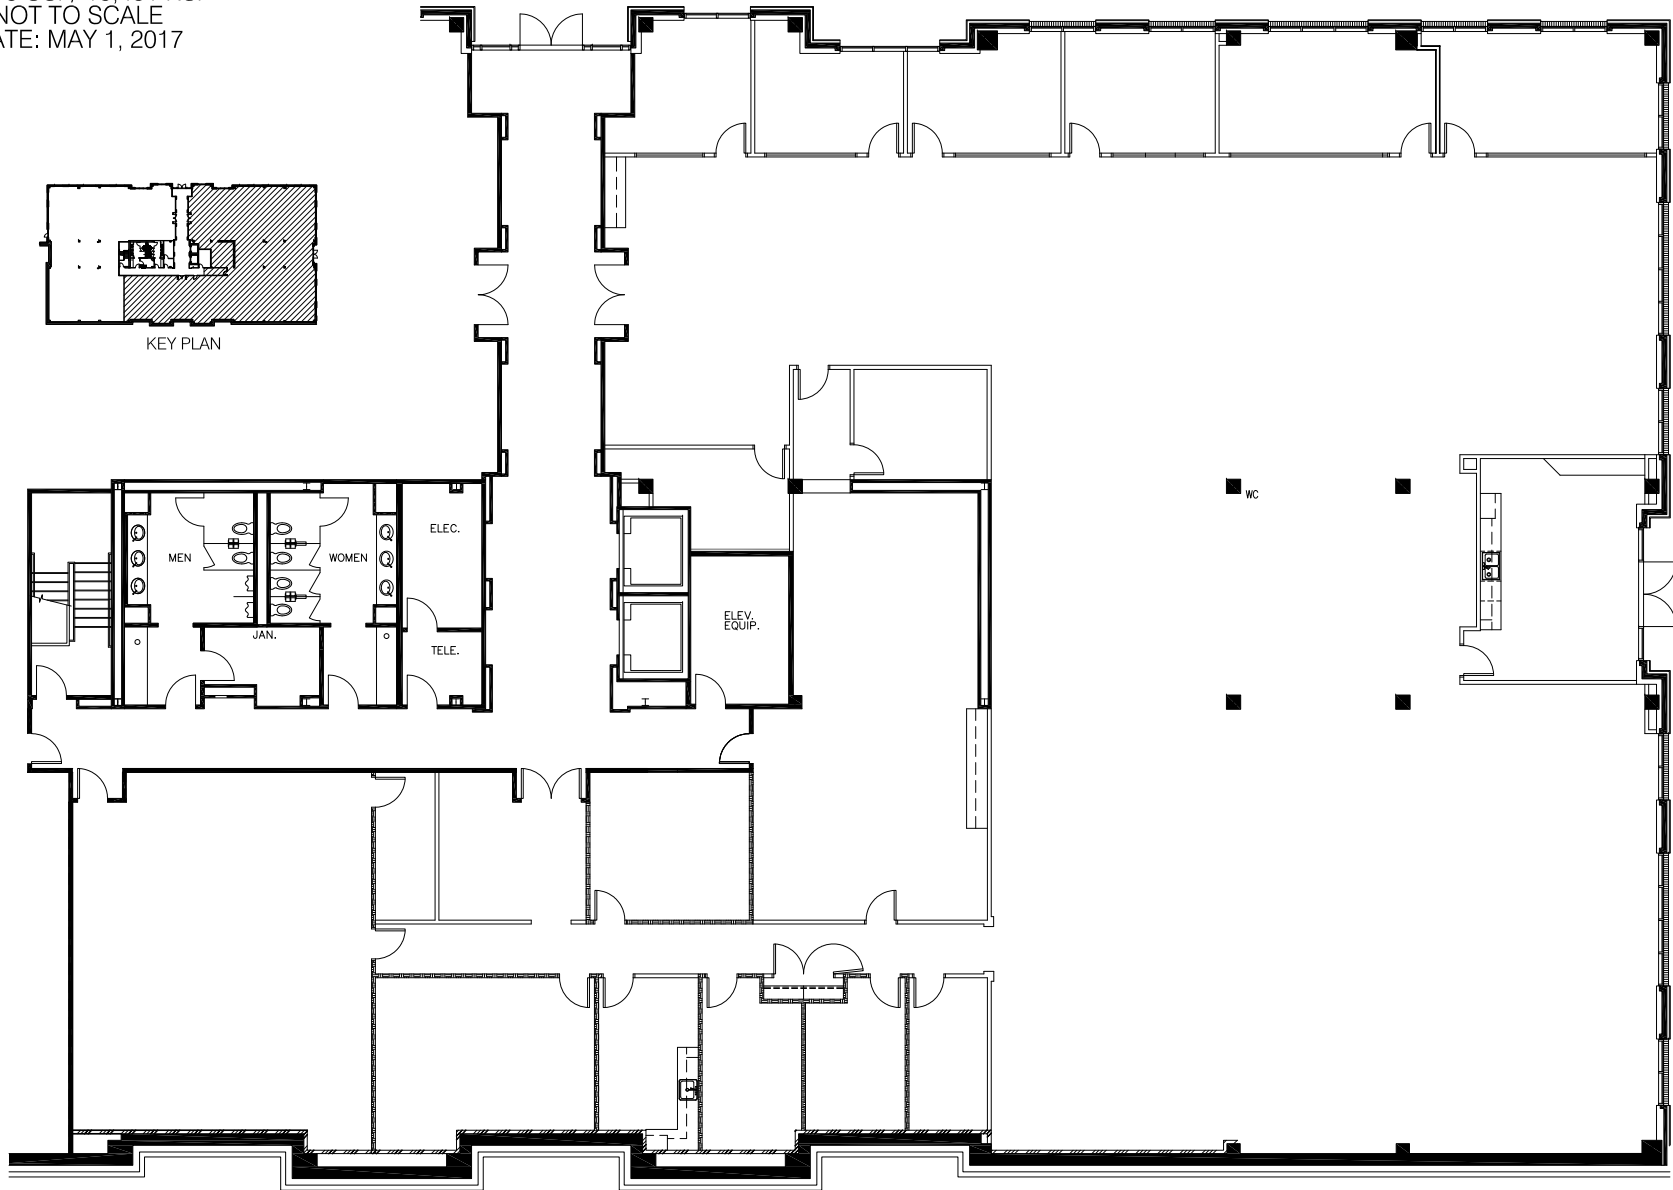

NORTHWOOD
OFFICE

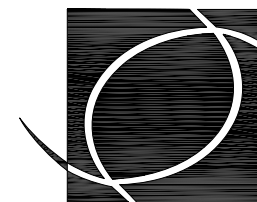

**SMITH
HARRIS**
DESIGN
associates