




SUITE 100  
AS-BUILT - 1 OF 1  
GIBSON BUILDING - LEVEL ONE  
15,565 RSF  
NOT TO SCALE  
DATE: SEPTEMBER 19, 2018

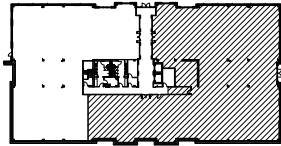

KEY PLAN

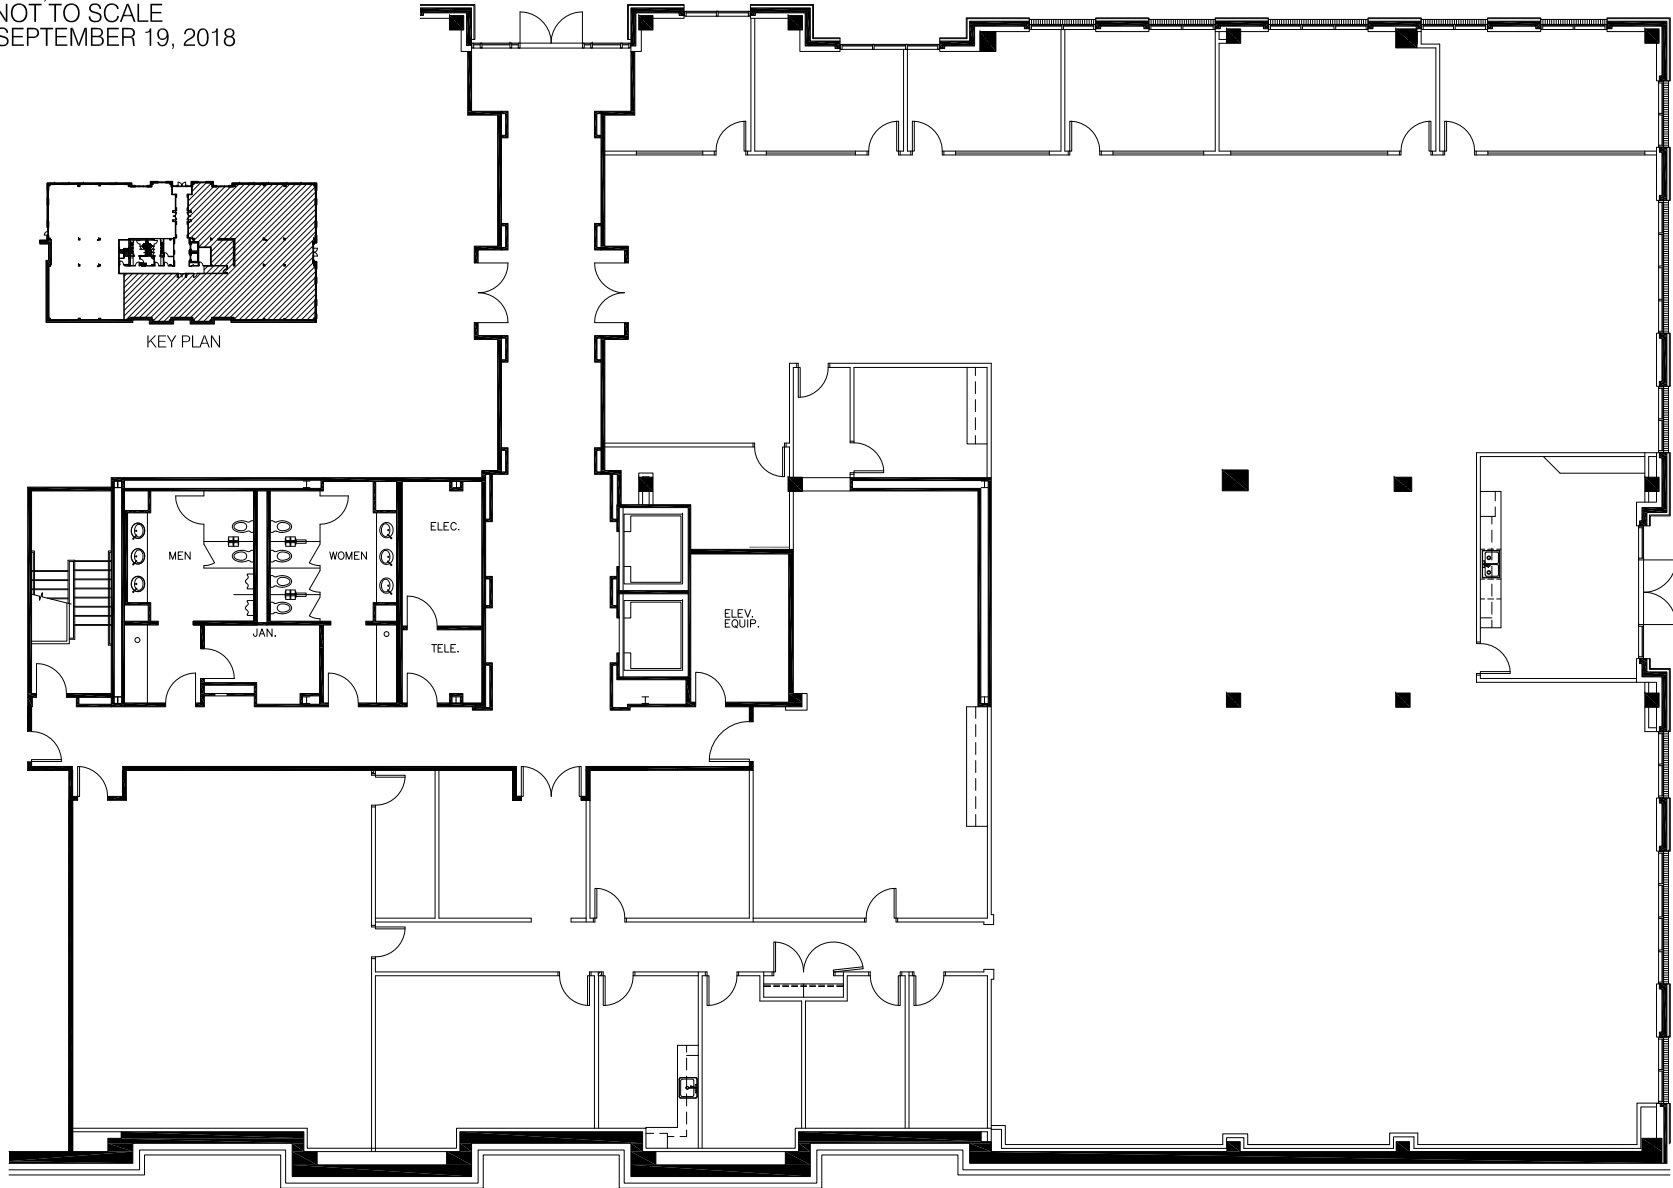

**NORTHWOOD**  
OFFICE

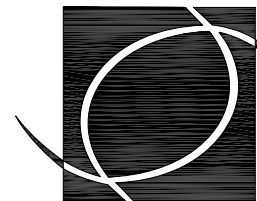

**SMITH  
HARRIS**  
**DESIGN**  
associates