




SUITE 125
AS BUILT - 1 OF 1
HALL BUILDING - LEVEL ONE
5,350 USF / 6,153 RSF
NOT TO SCALE
DATE: MAY 2, 2017

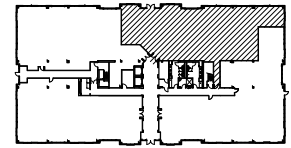

KEY PLAN

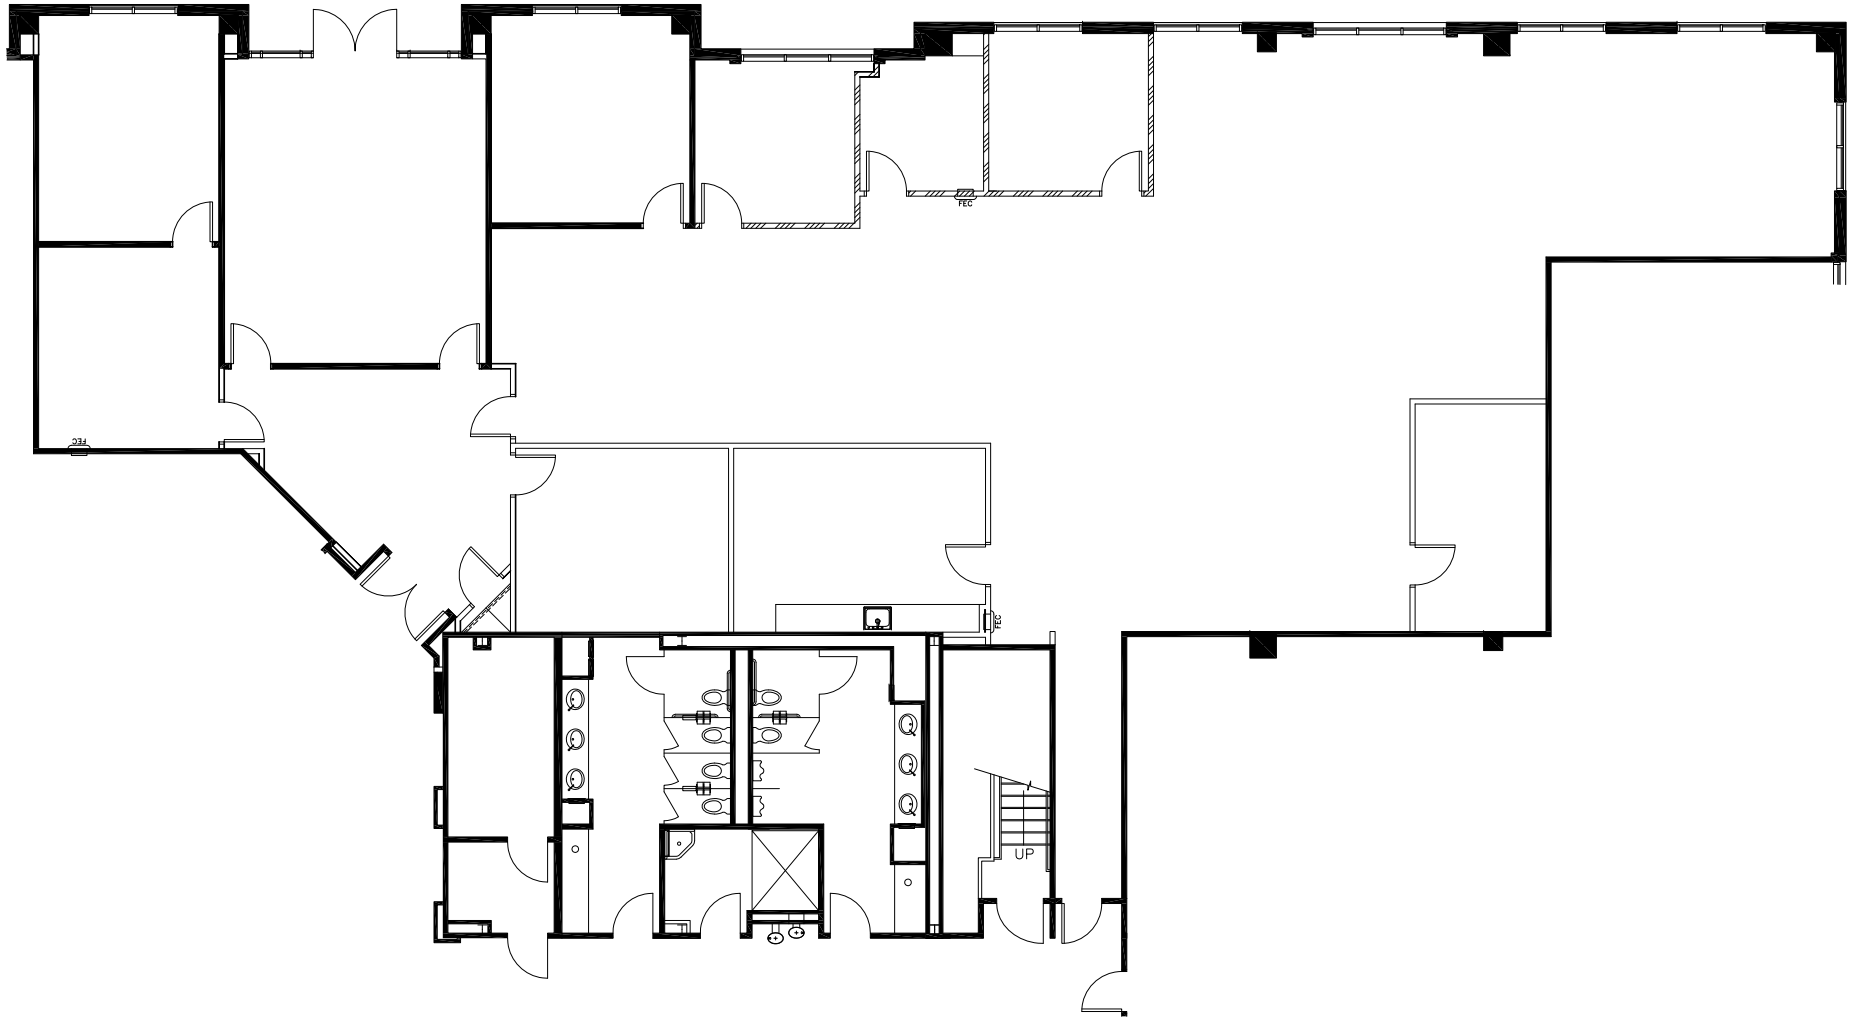

NORTHWOOD
OFFICE

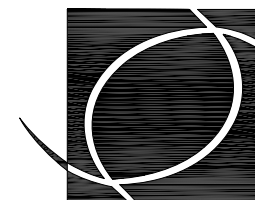

**SMITH
HARRIS
DESIGN**
associates