




SUITE 150  
AS BUILT - 1 OF 1  
CRAWFORD BUILDING - LEVEL TWO  
5,780 USF / 6,705 RSF  
NOT TO SCALE  
DATE: OCTOBER 15, 2018

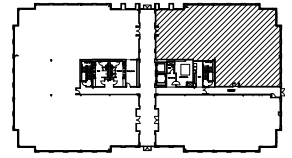

KEY PLAN

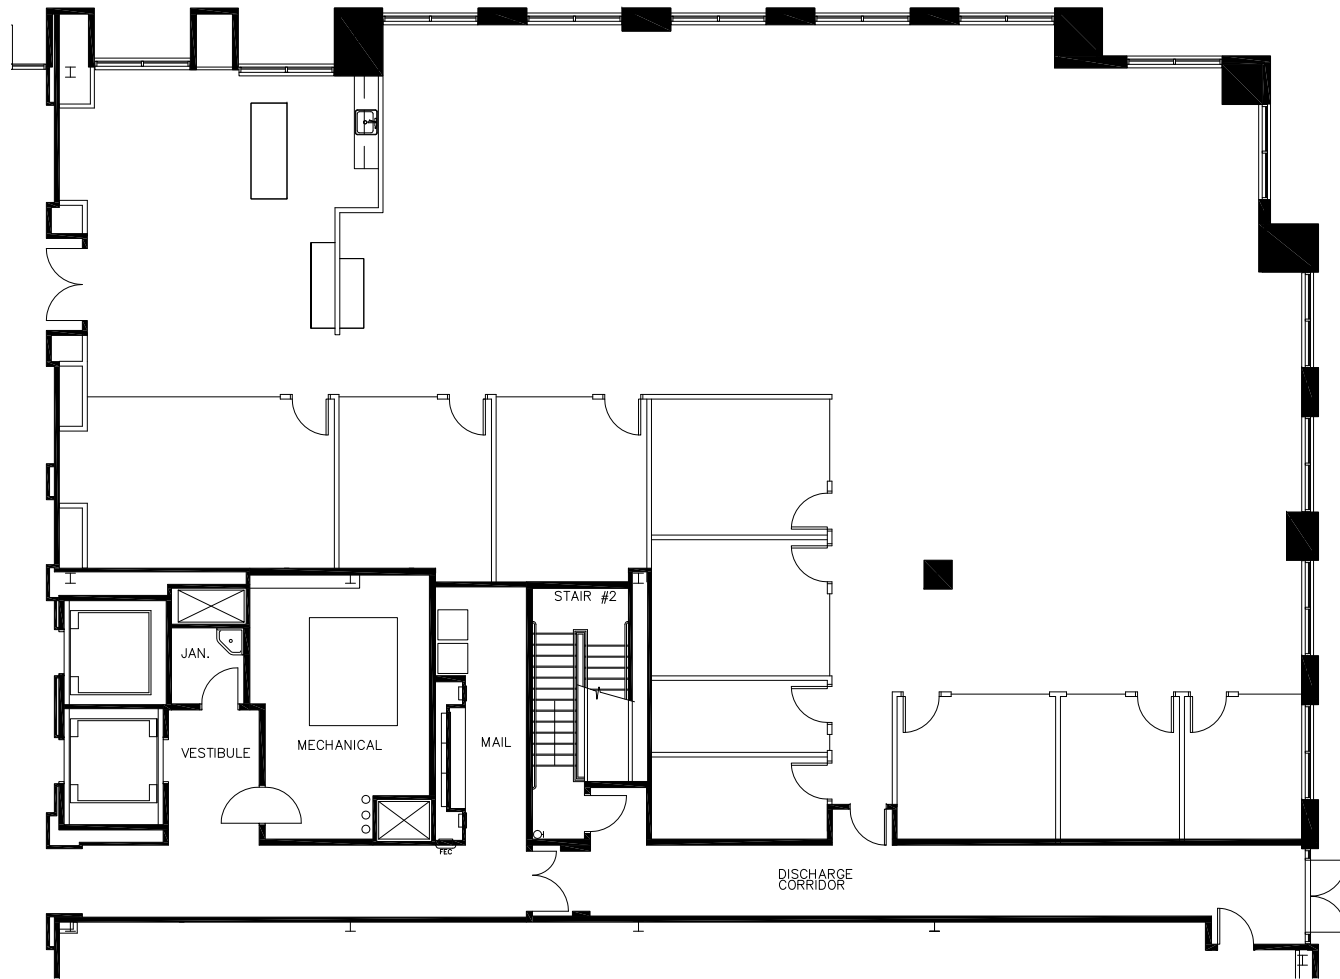

**NORTHWOOD**  
OFFICE

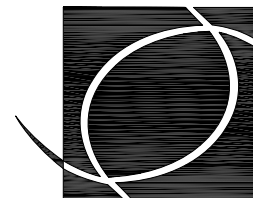

**SMITH  
HARRIS  
DESIGN**  
associates