


Chandler Building

SUITE 300
22,524 USF / 25,902 RSF

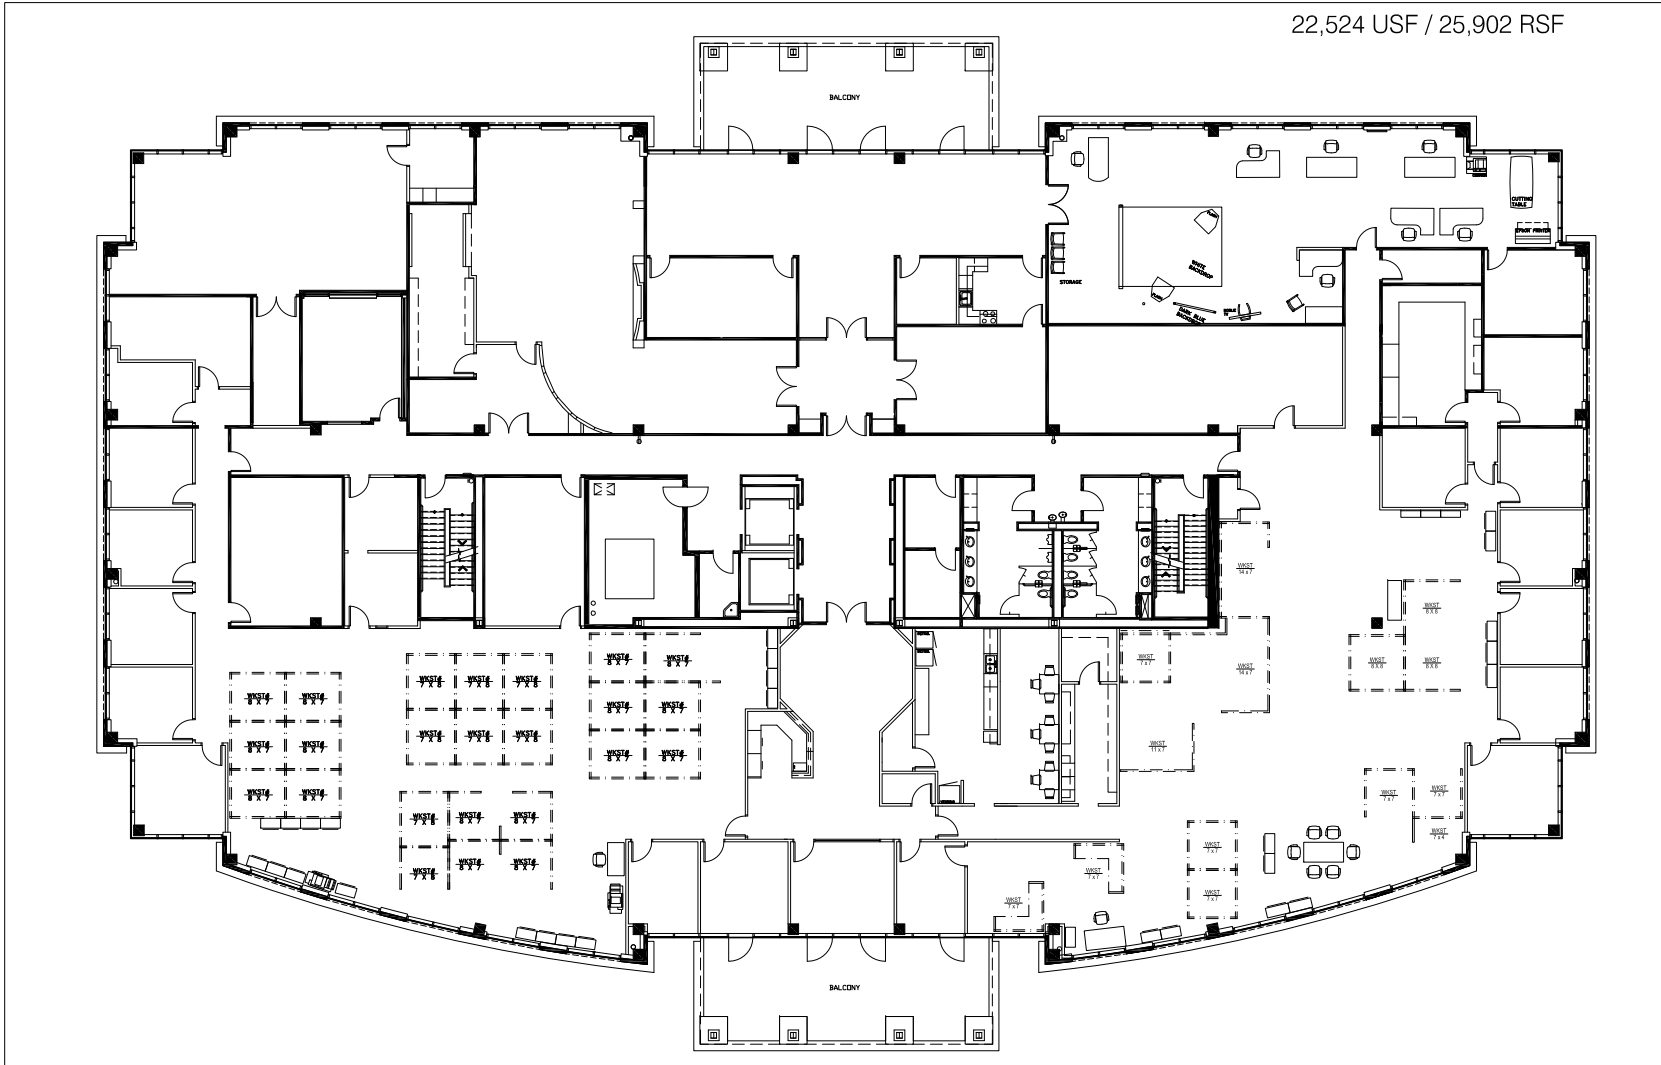

13860 Ballantyne Corporate Place

Level Three

As Built

February 15, 2017

Not to Scale



13860 Ballantyne Corporate Place
Suite 300
Charlotte, N.C. 28277
(704) 248-2000
www.bissell-companies.com



**SMITH
HARRIS
DESIGN**
associates