




SUITE 520
AS-BUILT - 1 OF 1
CULLMAN PARK - LEVEL FIVE
6,017 RSF
NOT TO SCALE
DATE: NOVEMBER 29, 2018

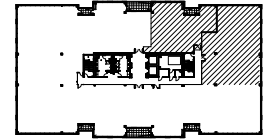

KEY PLAN

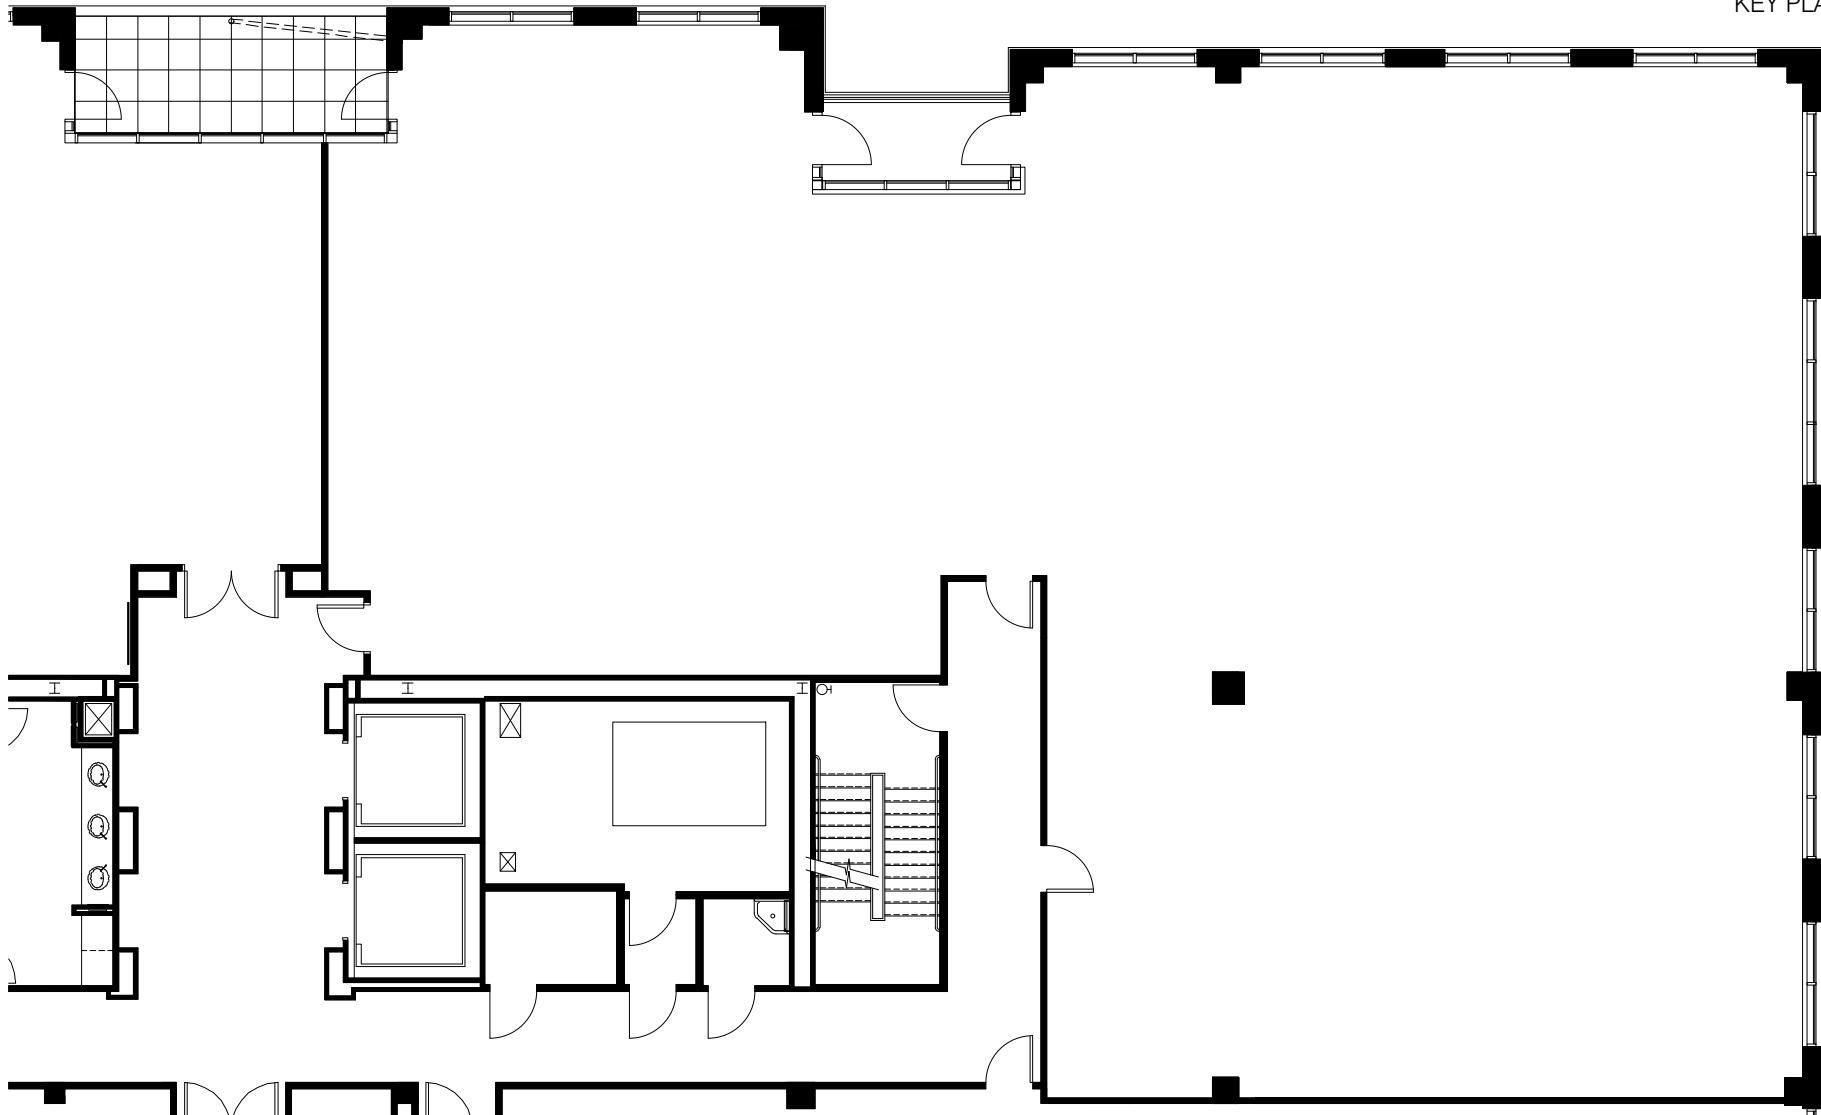

NORTHWOOD
OFFICE

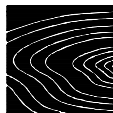

**SMITH
HARRIS**
DESIGN
associates