





SUITE 520
AS-BUILT - 1 OF 1
CULLMAN PARK - LEVEL FIVE
5,048 USF/ 5,805 RSF
NOT TO SCALE
DATE: NOVEMBER 7, 2017

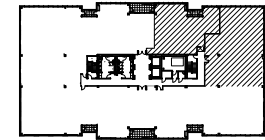

KEY PLAN

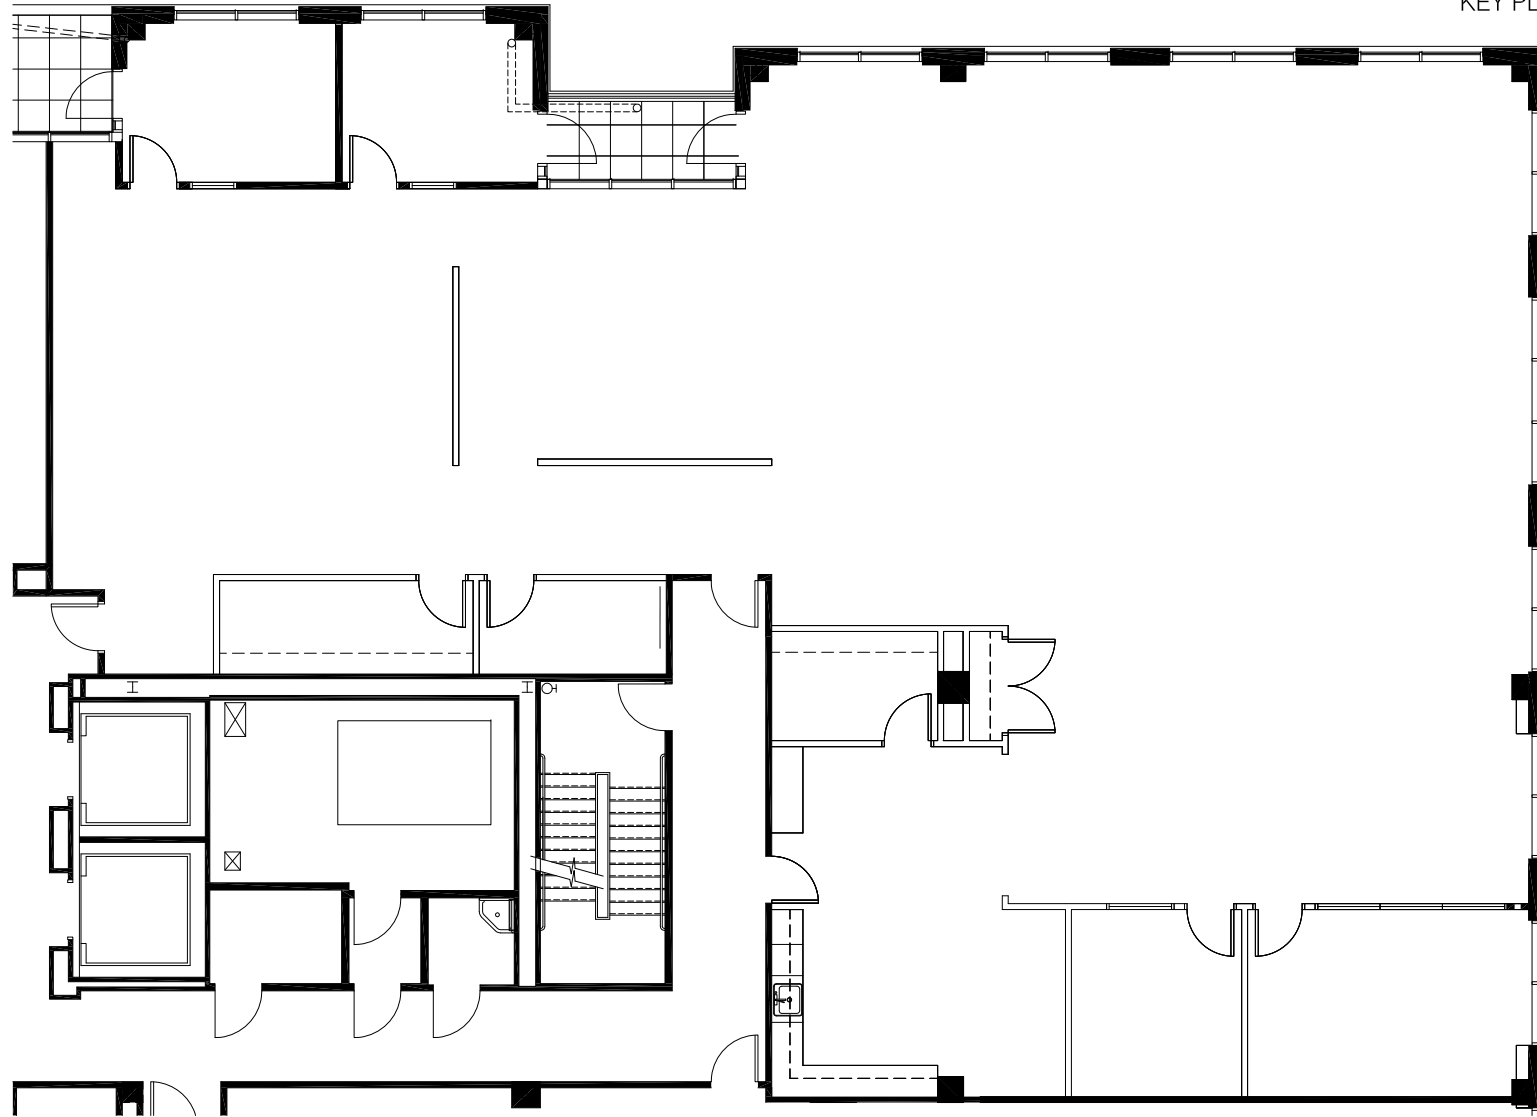

NORTHWOOD
OFFICE

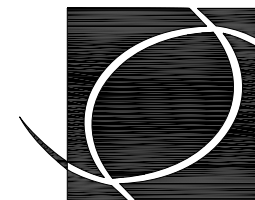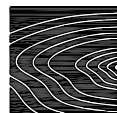

**SMITH
HARRIS**
DESIGN
associates