



SUITE 150


AS BUILT PLAN - 1 OF 1
BRIXHAM GREEN ONE - LEVEL ONE
3,316 USF/ 3,847 RSF
SCALE: 3/32" = 1'-0"
DATE: AUGUST 23, 2018

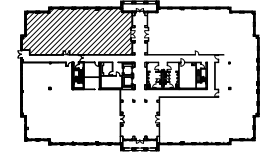

KEY PLAN

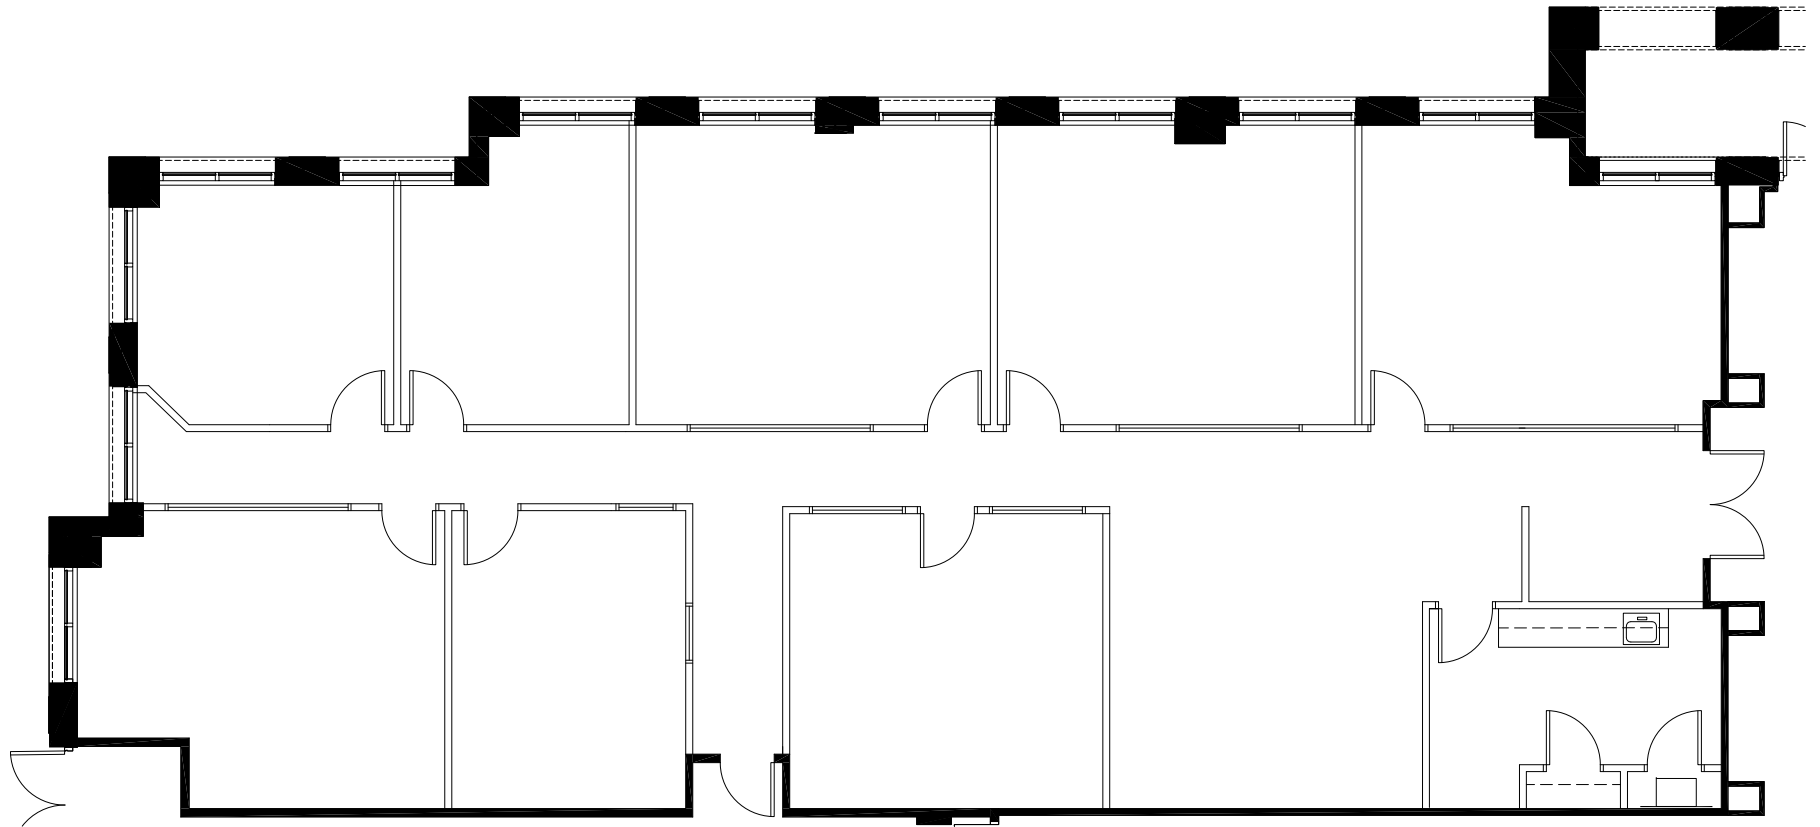

NORTHWOOD
OFFICE

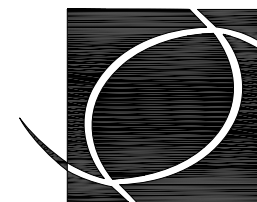

**SMITH
HARRIS**
DESIGN
associates