




SUITE 400
AS BUILT - 1 OF 1
BRIXHAM GREEN THREE - LEVEL FOUR
13,032 USF / 14,987 RSF
NOT TO SCALE
DATE: APRIL 19, 2017

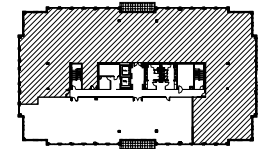

KEY PLAN

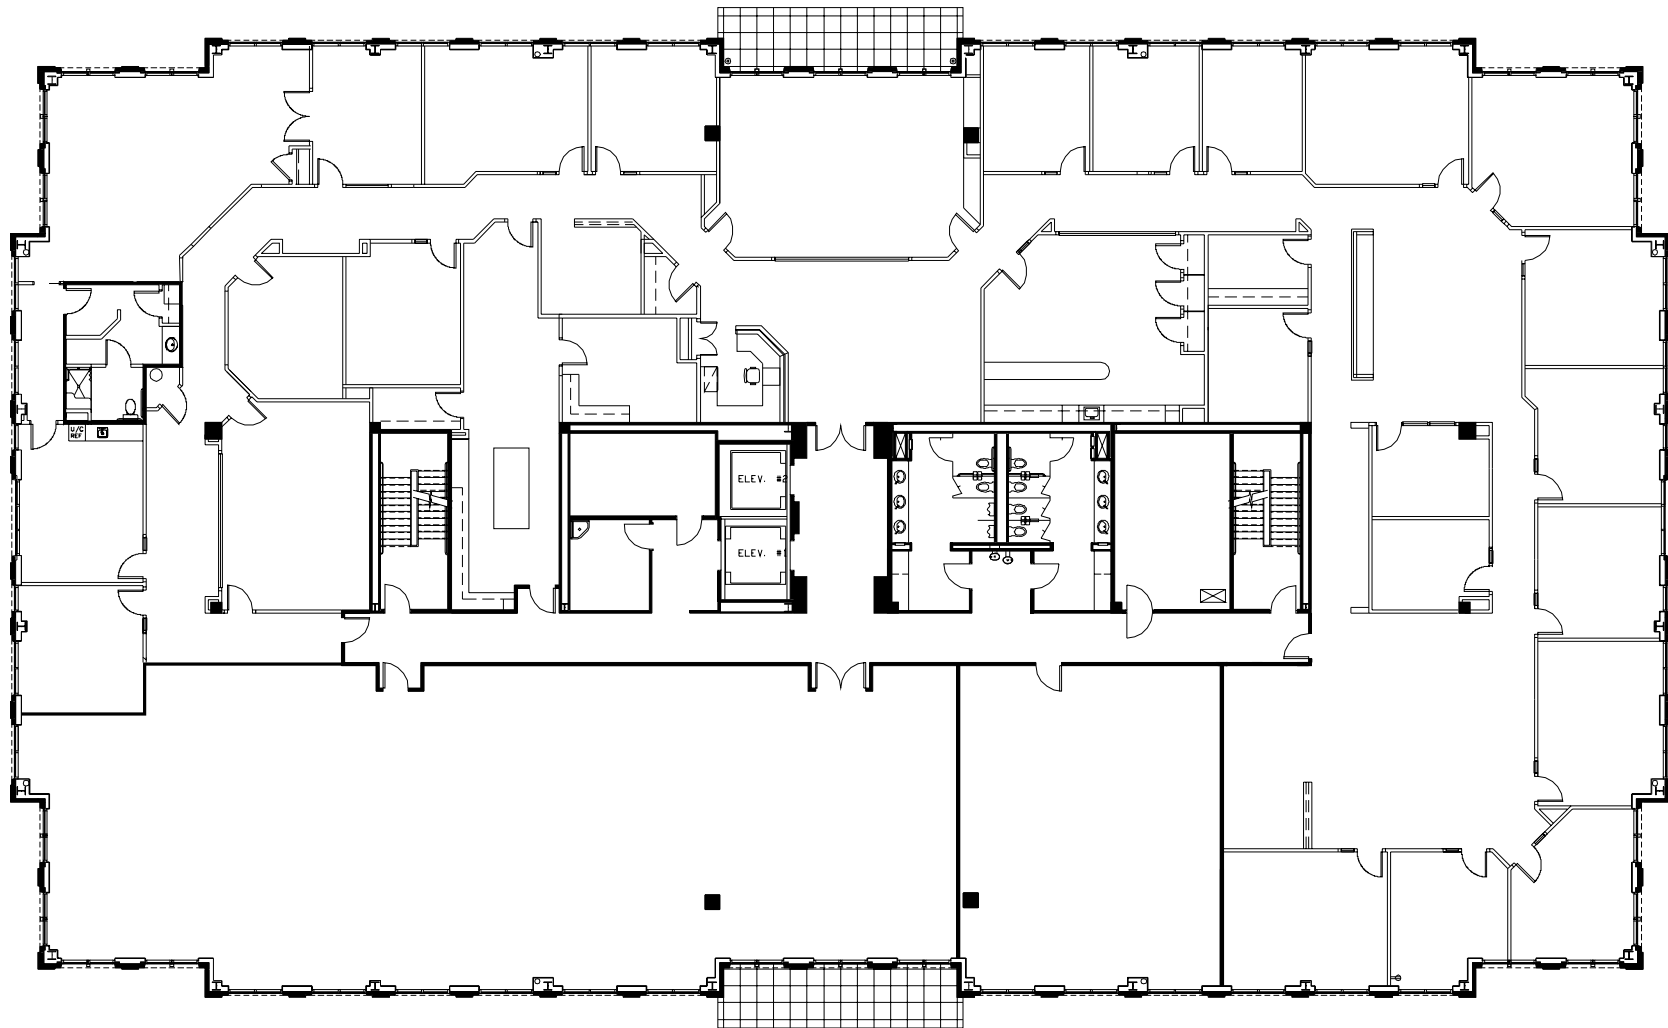

NORTHWOOD
OFFICE

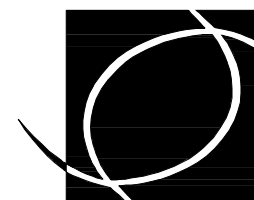

**SMITH
HARRIS**
DESIGN
associates