





SUITE 400
AS BUILT - 1 OF 1
BRIXHAM GREEN THREE - LEVEL FOUR
15,309 RSF
NOT TO SCALE
DATE: NOVEMBER 29, 2018

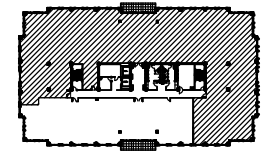

KEY PLAN

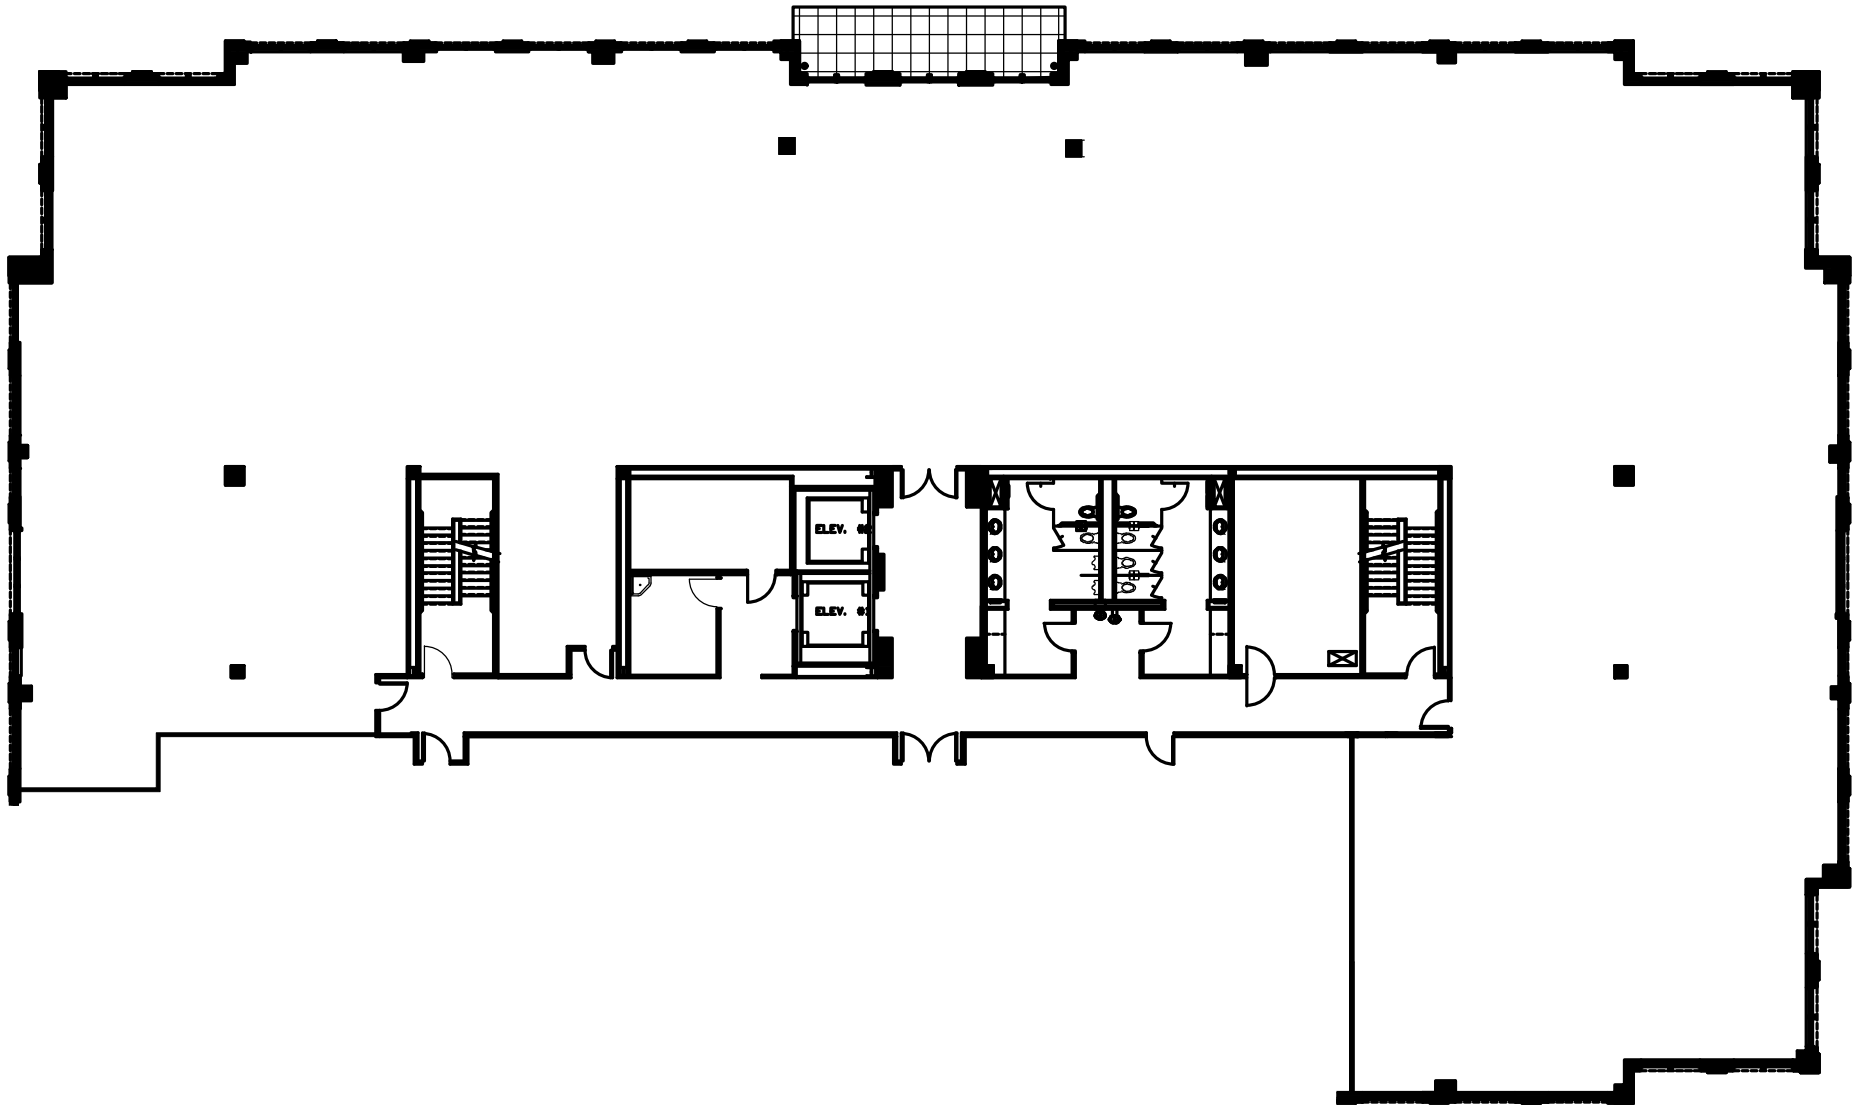

NORTHWOOD
OFFICE

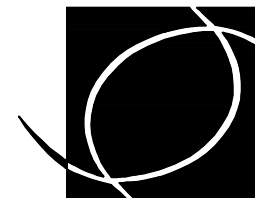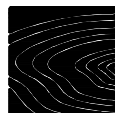

**SMITH
HARRIS**
DESIGN
associates