

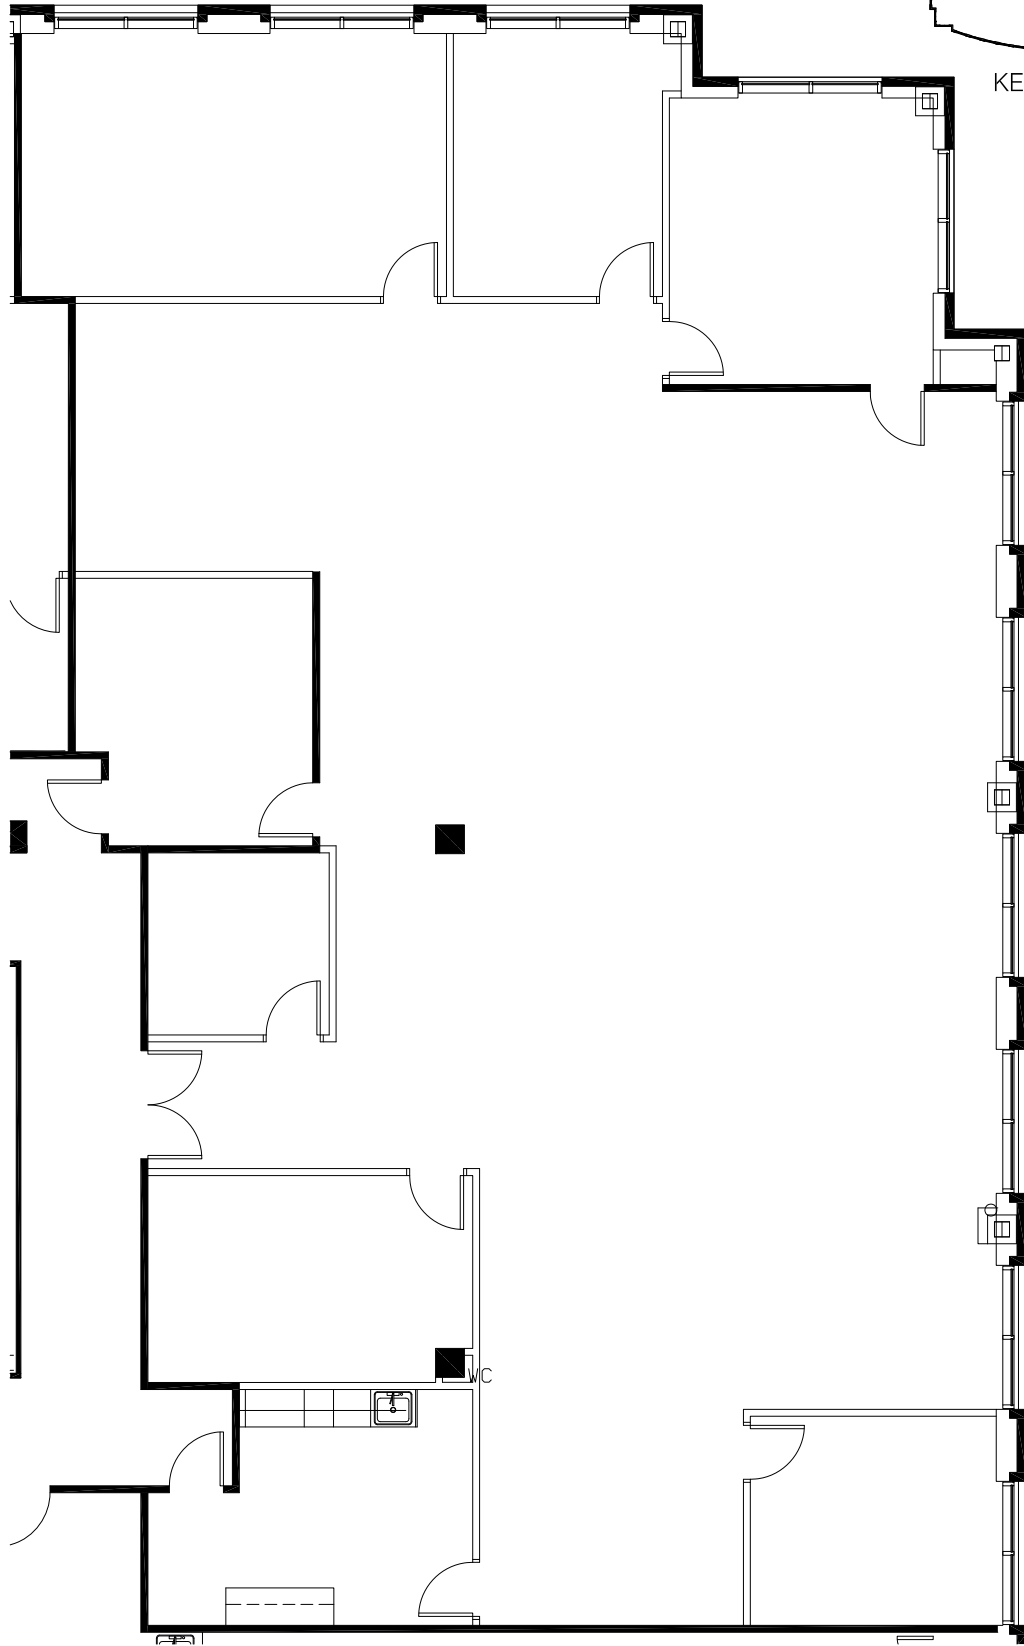


SUITE 130
AS BUILT - 1 OF 1
CHANDLER BUILDING - LEVEL ONE
4,432 USF/5,097 RSF
SCALE: 3/32" = 1'-0"
DATE: MARCH 6, 2018

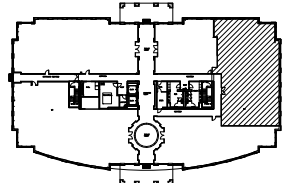

NORTHWOOD
OFFICE

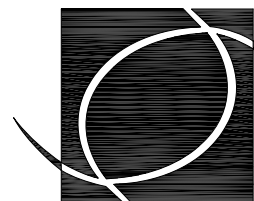

**SMITH
HARRIS**
DESIGN
associates