

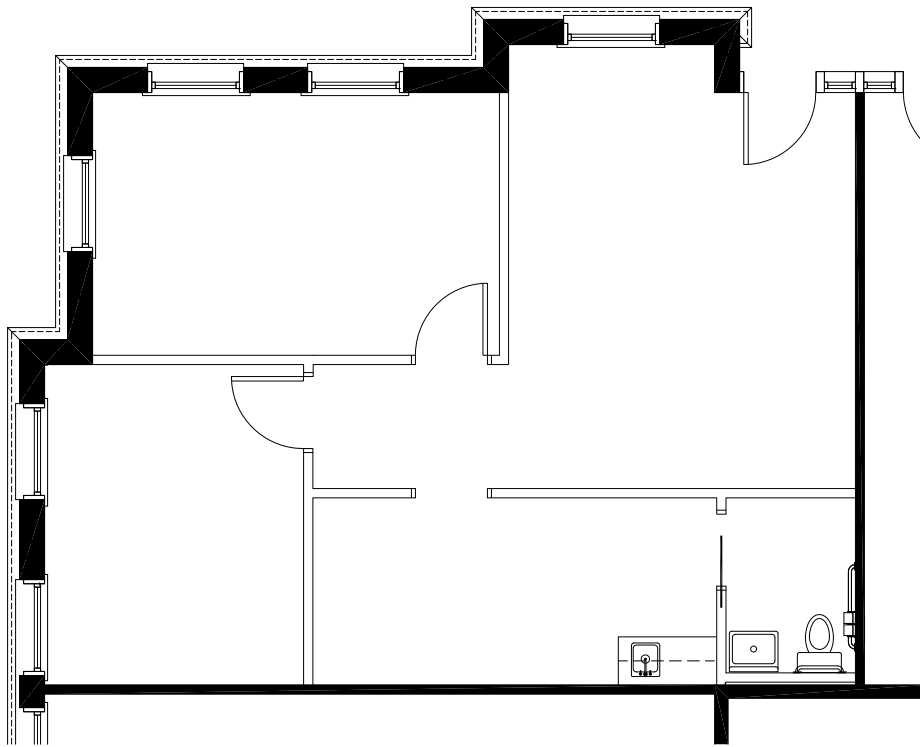


SUITE 175
AS BUILT PLAN - 1 OF 1
CORPORATE VILLA C - LEVEL ONE
844 RSF
SCALE: 1/8" = 1'-0"
DATE: APRIL 20, 2018

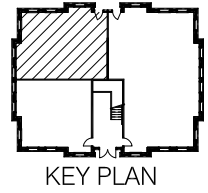

NORTHWOOD
OFFICE

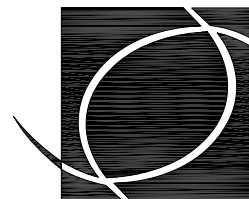

**SMITH
HARRIS**
DESIGN
associates