



SUITE 125
AS BUILT - 1 OF 1
HIXON BUILDING - LEVEL ONE
4,484 USF / 5,157 RSF
NOT TO SCALE
DATE: SEPTEMBER 21, 2017

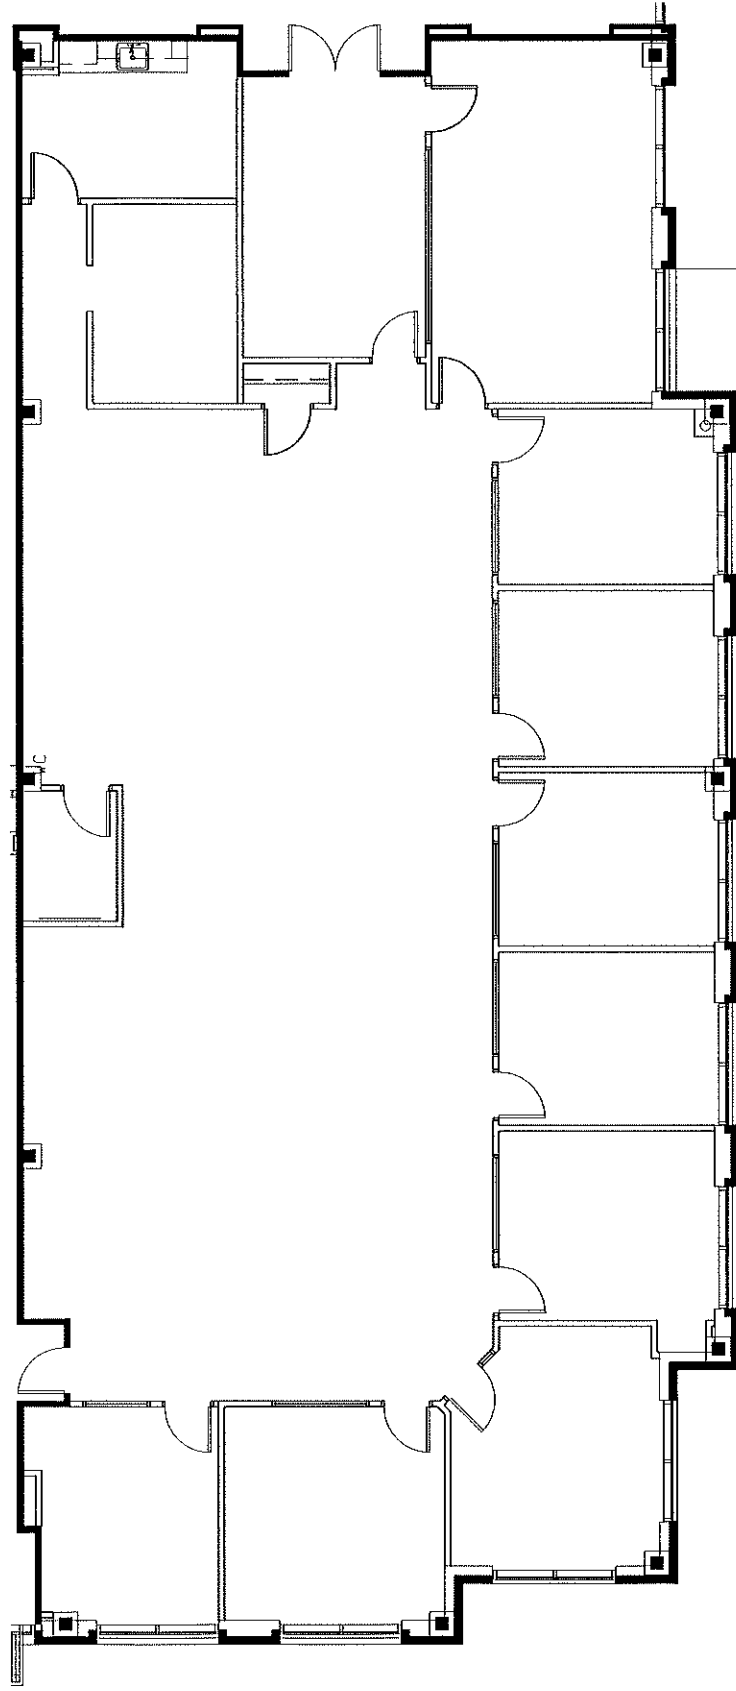

NORTHWOOD
OFFICE

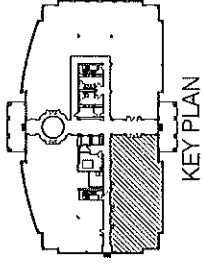

SMITH
HARRIS
DESIGN
ASSOCIATES