


SUITE 110
AS BUILT - 1 OF 1
RICHARDSON - LEVEL ONE
1,161 USF / 1,335 RSF
SCALE: 1/8" = 1'-0"
DATE: APRIL 4, 2017

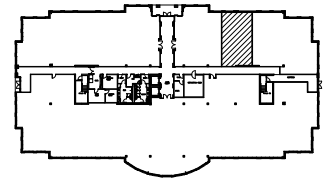

KEY PLAN

