




SUITE 400  
AS BUILT - 1 OF 1  
BALLANTYNE ONE - LEVEL FOUR  
2,308 USF / 2,654 RSF  
SCALE: 1/8" = 1'-0"  
DATE: APRIL 13, 2017

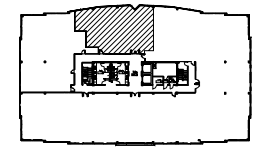

KEY PLAN

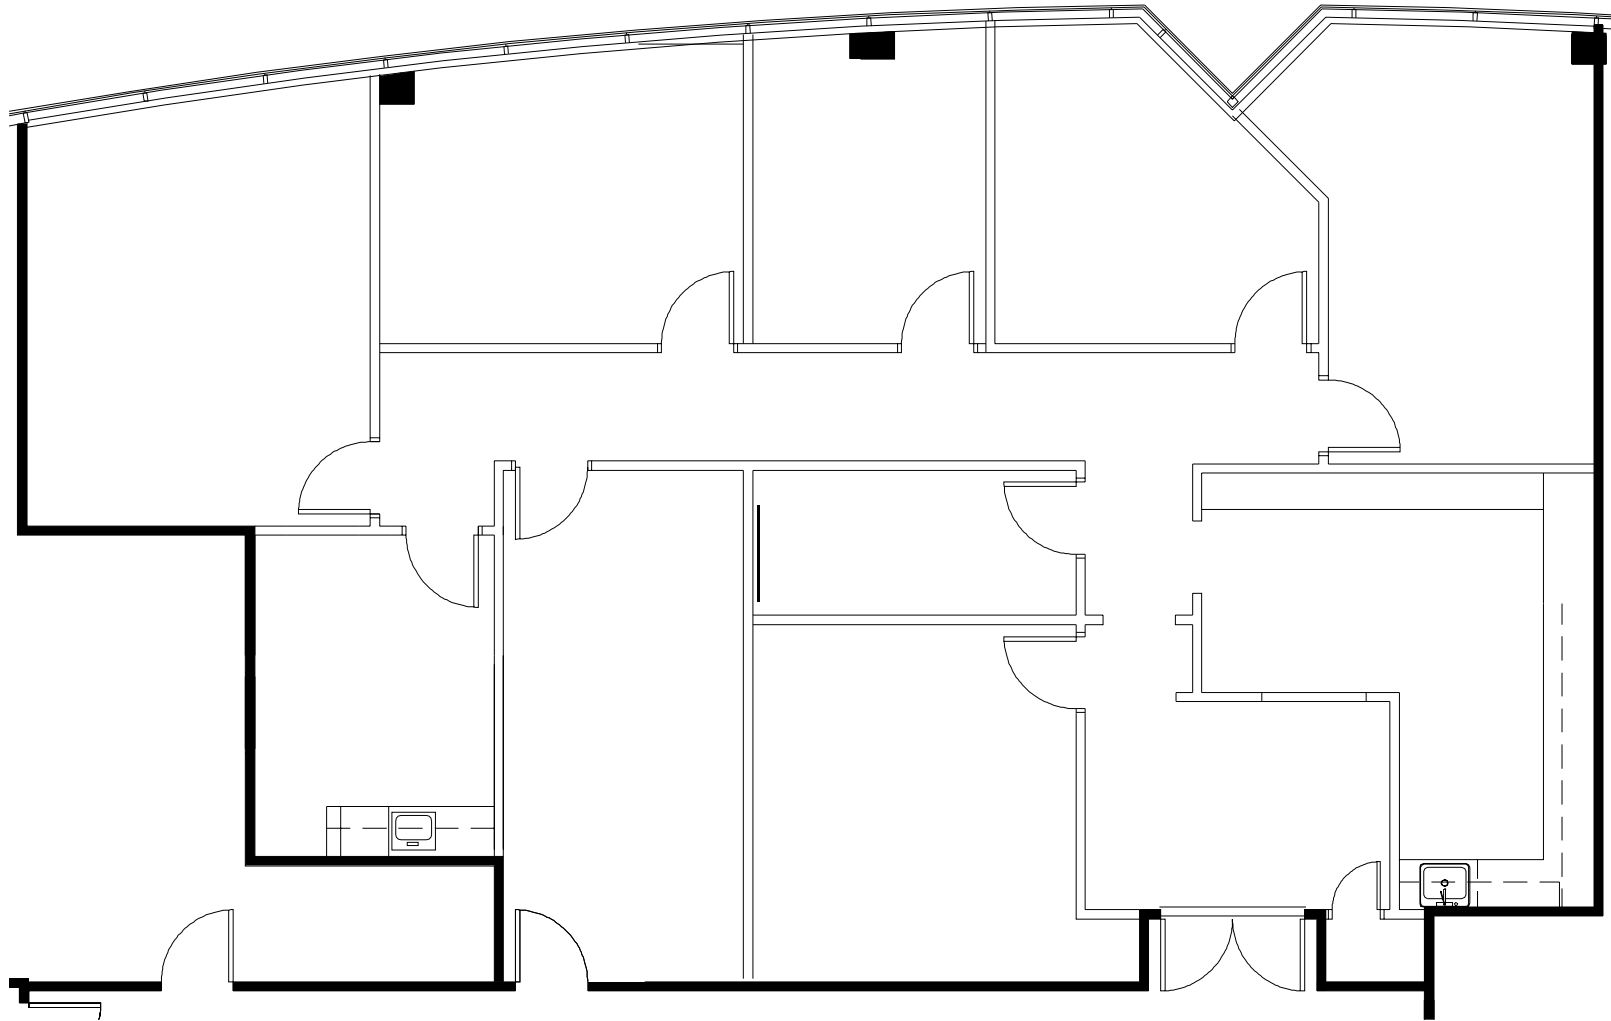

**NORTHWOOD**  
OFFICE

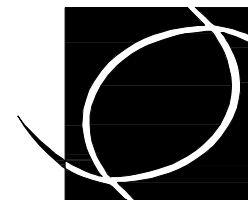

**SMITH  
HARRIS**  
DESIGN  
associates