




SUITE 300  
AS-BUILT PLAN - 1 OF 1  
CULLMAN PARK  
11,622 USF/13,365 RSF  
NOT TO SCALE  
DATE: JULY 11, 2018

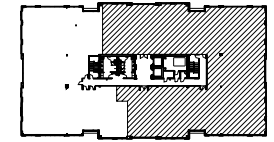

KEY PLAN

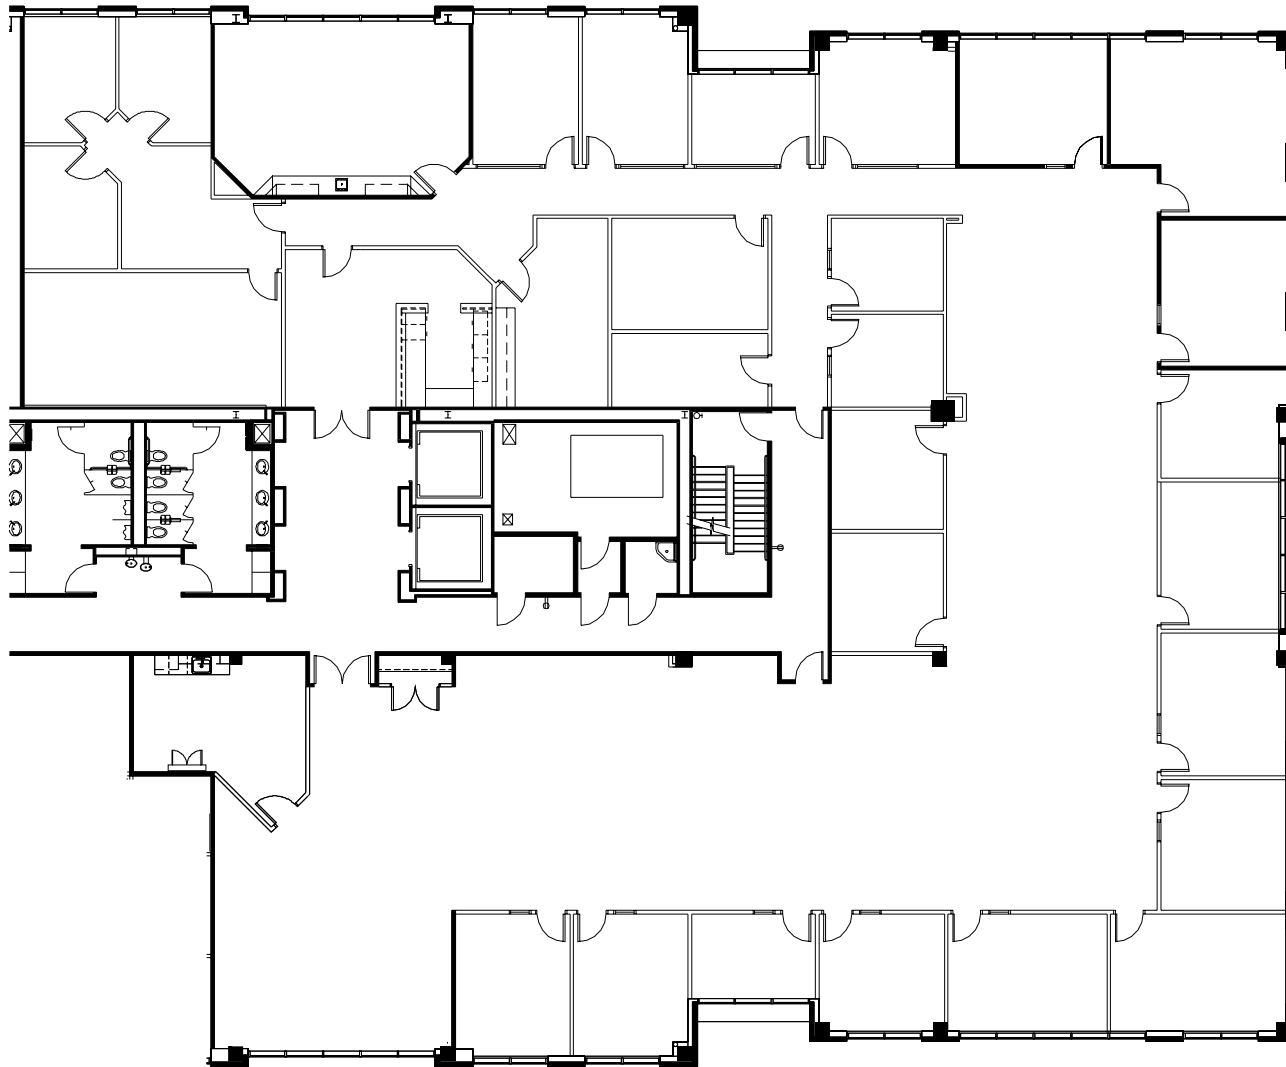

**NORTHWOOD**  
OFFICE

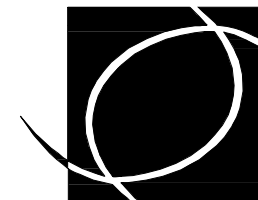

**SMITH  
HARRIS**  
**DESIGN**  
associates