





SUITE 250  
AS BUILT - 1 OF 1  
CHANDLER BUILDING - LEVEL TWO  
6,458 USF / 7,491RSF  
NOT TO SCALE  
DATE: OCTOBER 19, 2018

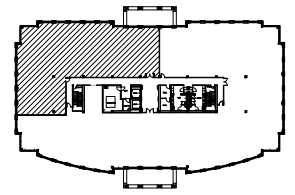

KEY PLAN

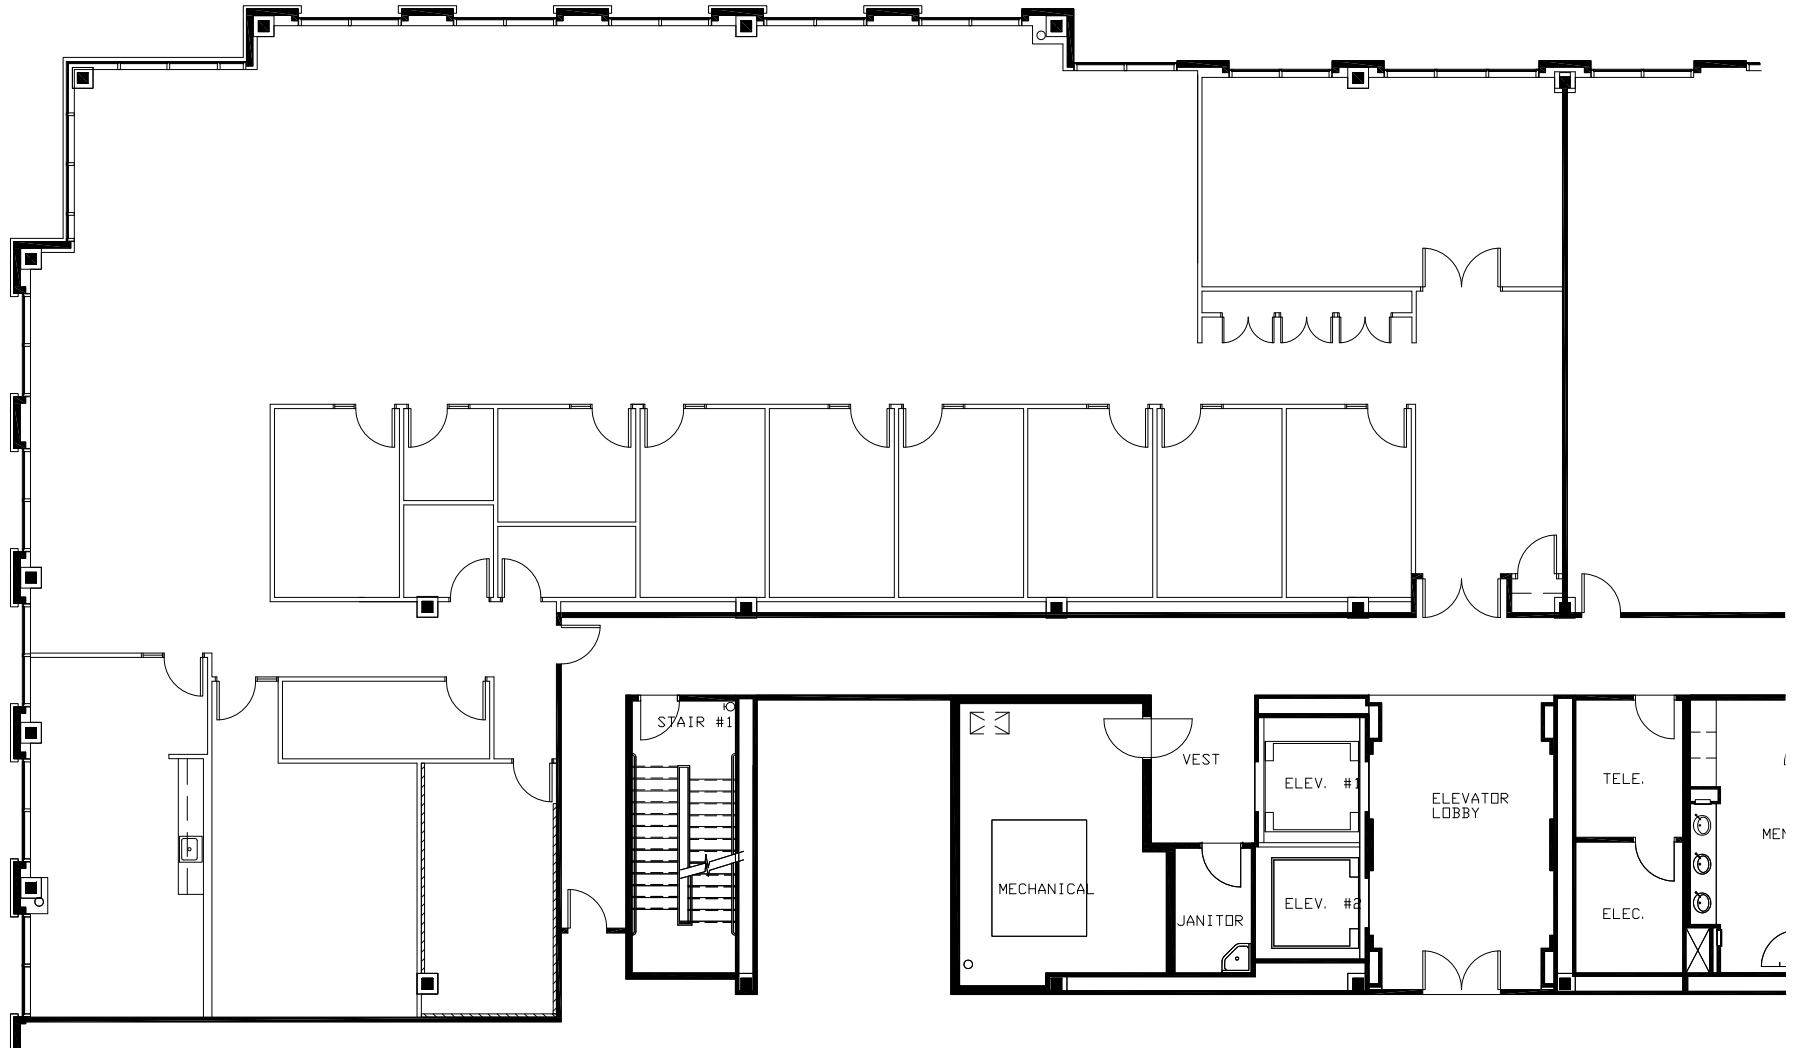

**NORTHWOOD**  
OFFICE

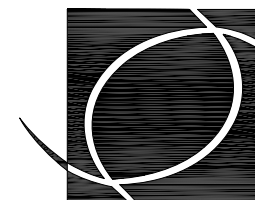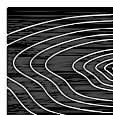

**SMITH  
HARRIS**  
**DESIGN**  
associates