



SUITE 250
 AS BUILT PLAN - 1 OF 1
 CORPORATE VILLA C - LEVEL TWO
 1,774 RSF
 SCALE: 1/8" = 1'-0"
 DATE: FEBRUARY 17, 2021

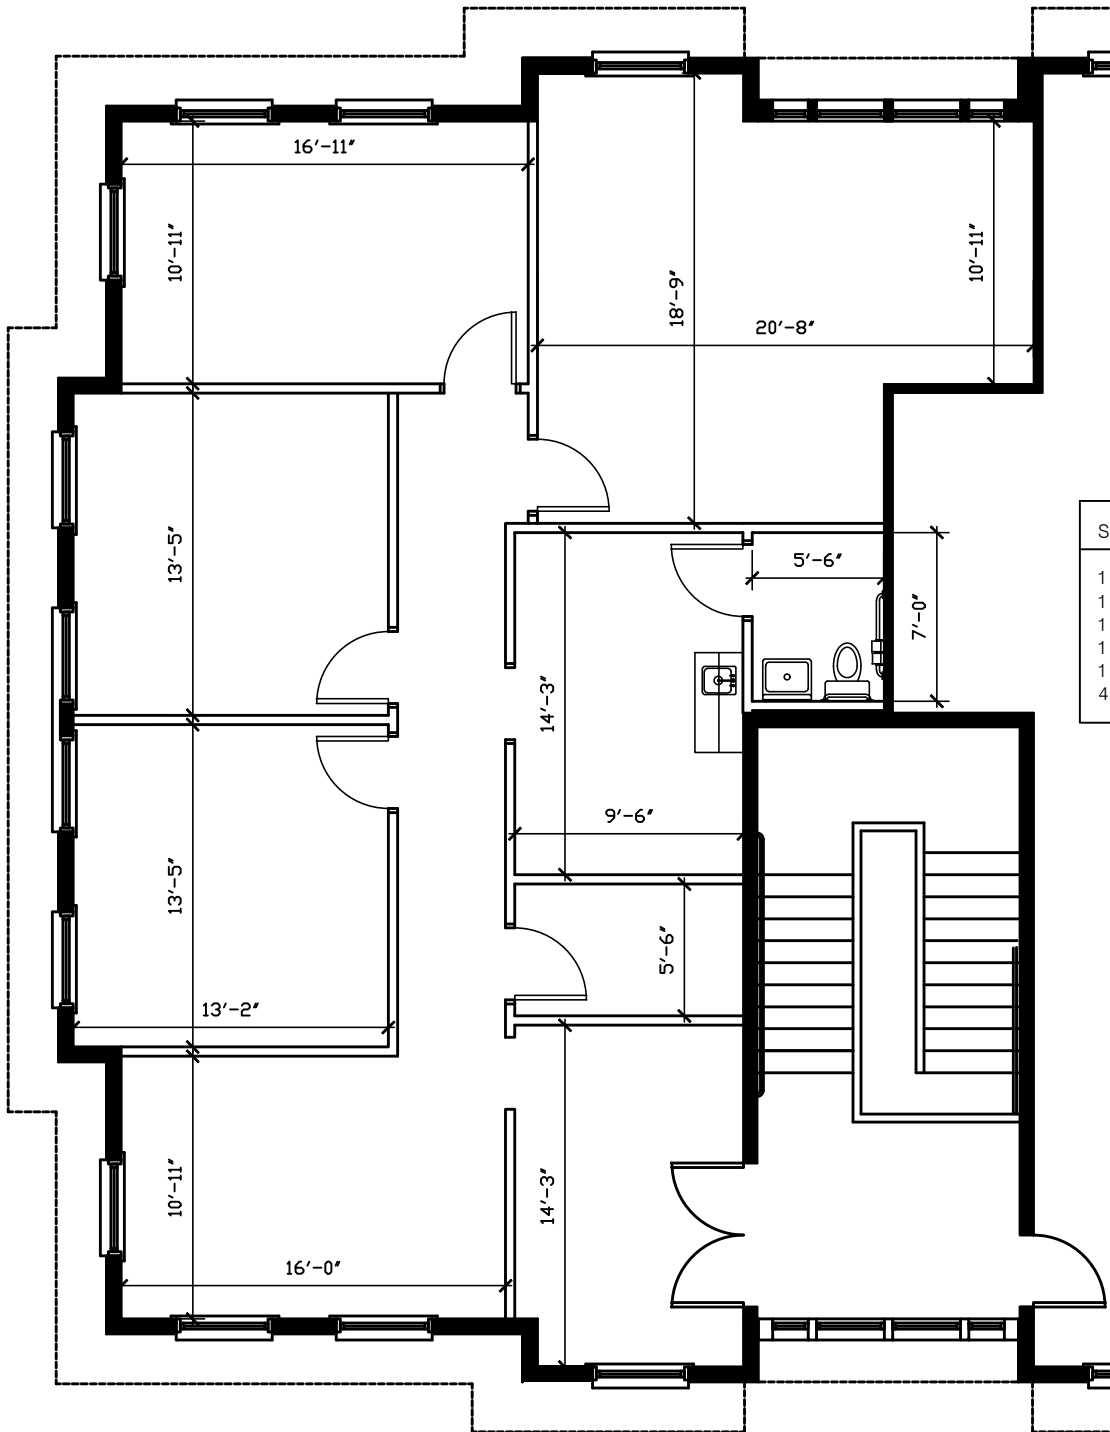

SUMMARY	
1	RECEPTION
1	OPEN AREA
1	STORAGE
1	BREAK ROOM
1	RESTROOM
4	PRIVATE OFFICE

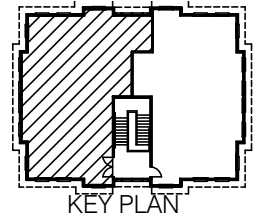