

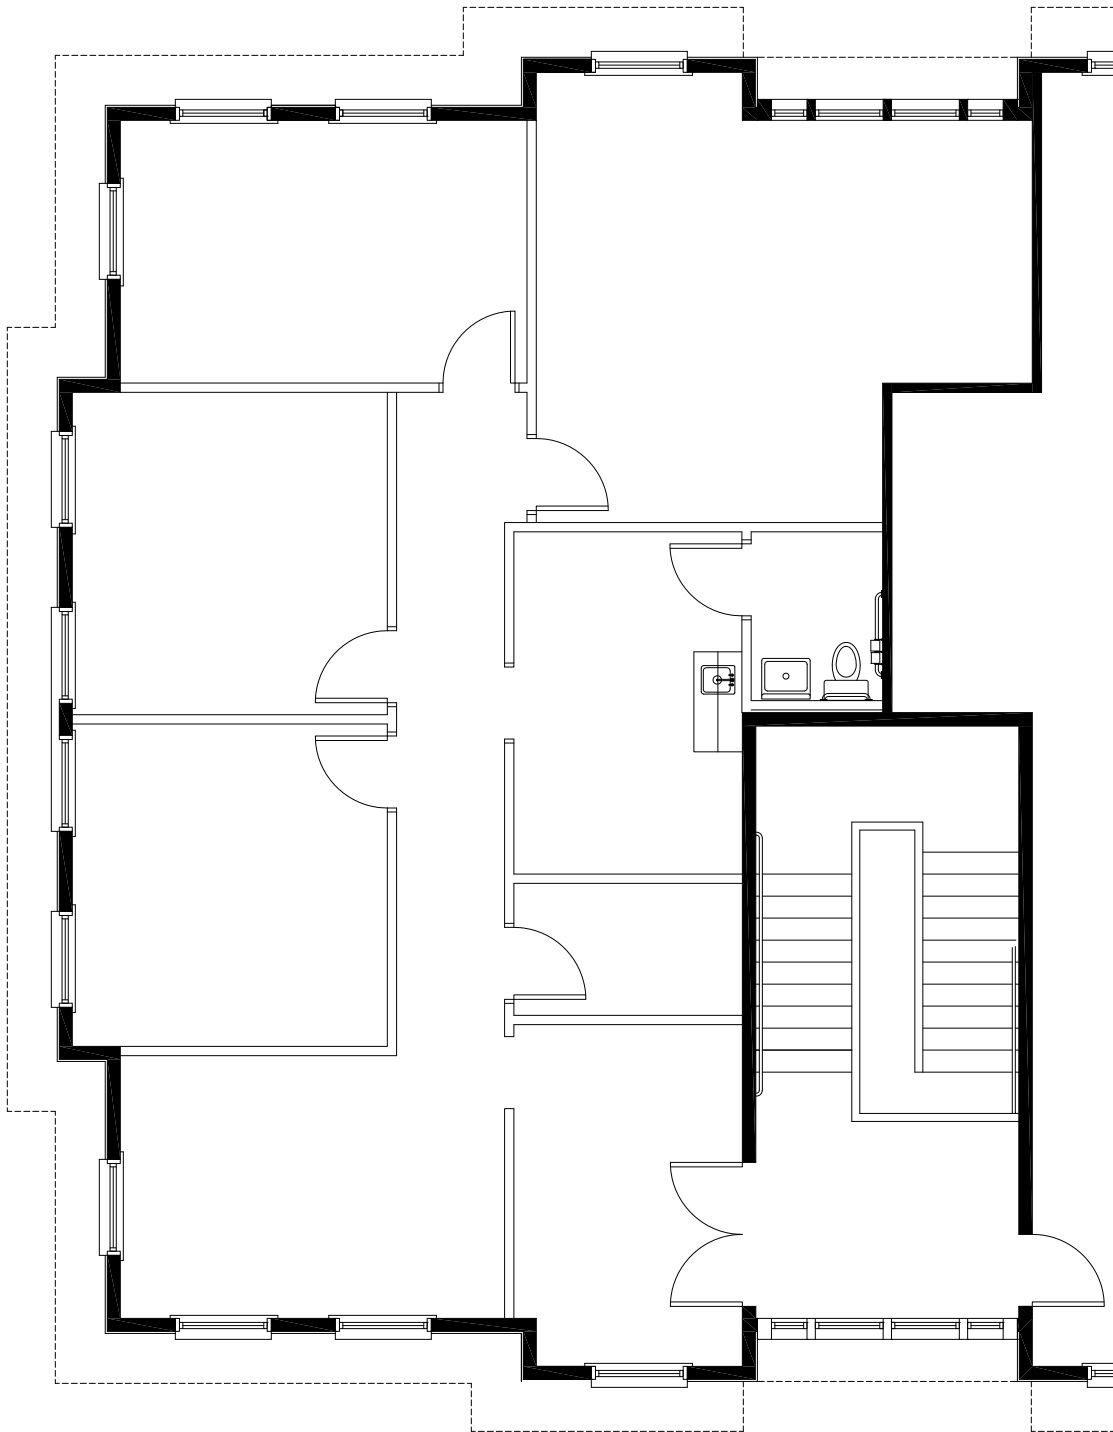
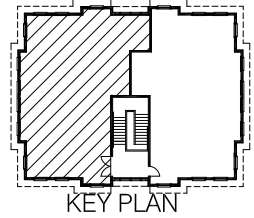


SUITE 250  
AS BUILT PLAN - 1 OF 1  
CORPORATE VILLA C - LEVEL TWO  
1,608 USF  
SCALE: 1/8" = 1'-0"  
DATE: OCTOBER 6, 2017

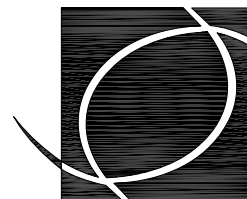

**NORTHWOOD**  
OFFICE

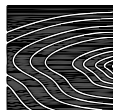

**SMITH  
HARRIS**  
DESIGN  
associates