





SUITE 225  
AS BUILT - 1 OF 1  
GIBSON BUILDING - SUITE 250  
8,104 RSF  
NOT TO SCALE  
DATE: OCTOBER 3, 2018

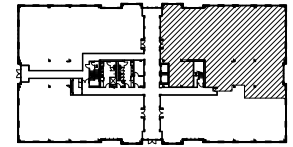

KEY PLAN

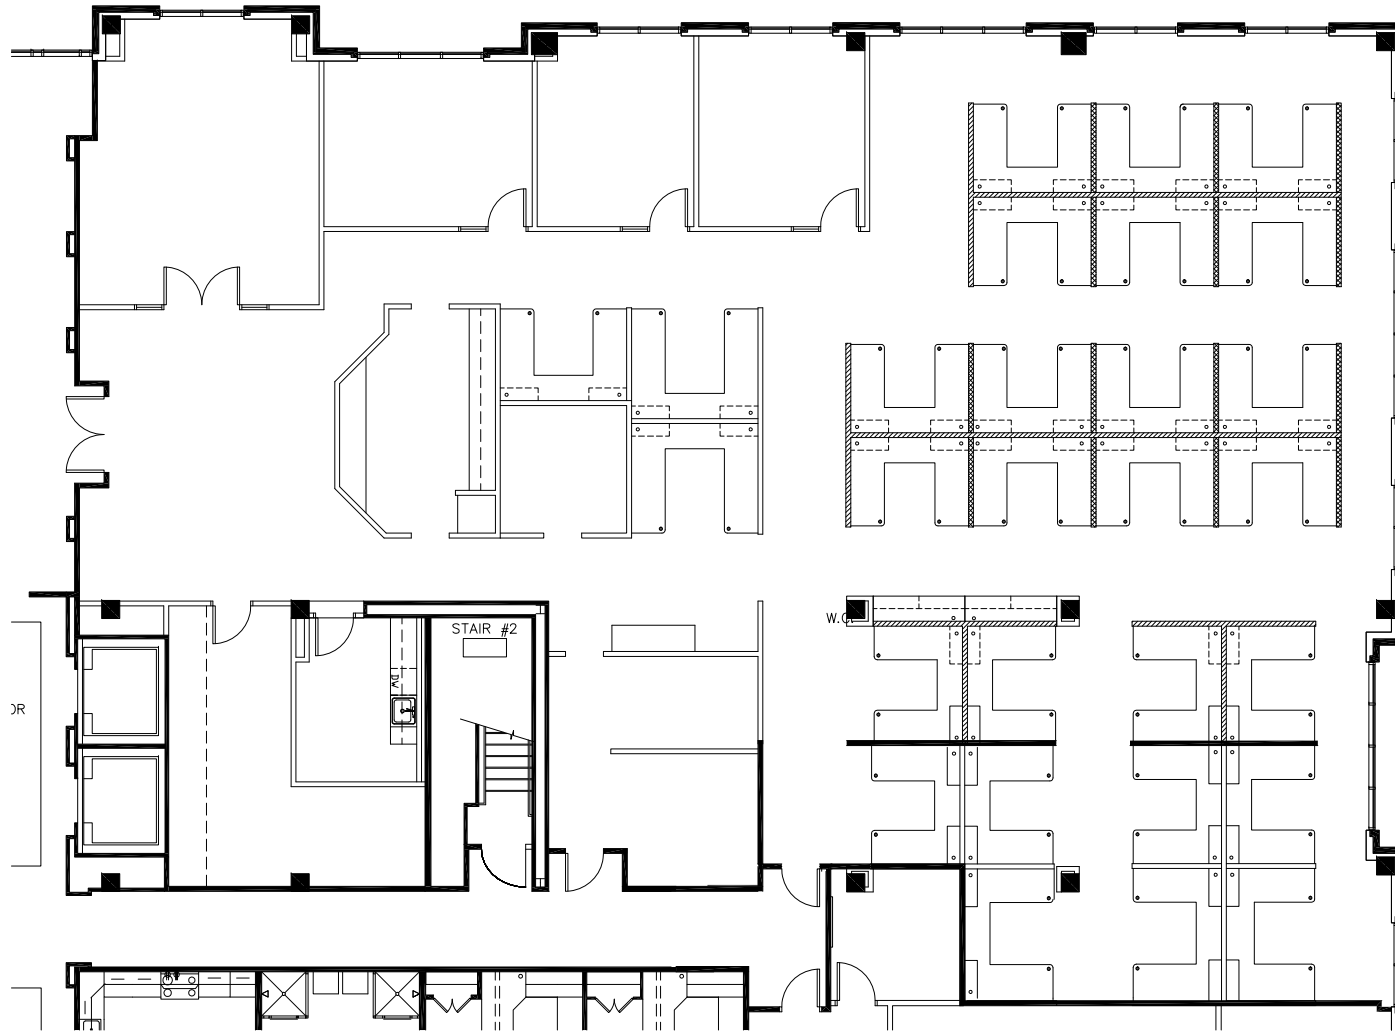

**NORTHWOOD**  
OFFICE

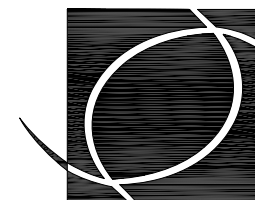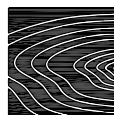

**SMITH  
HARRIS  
DESIGN**  
associates