

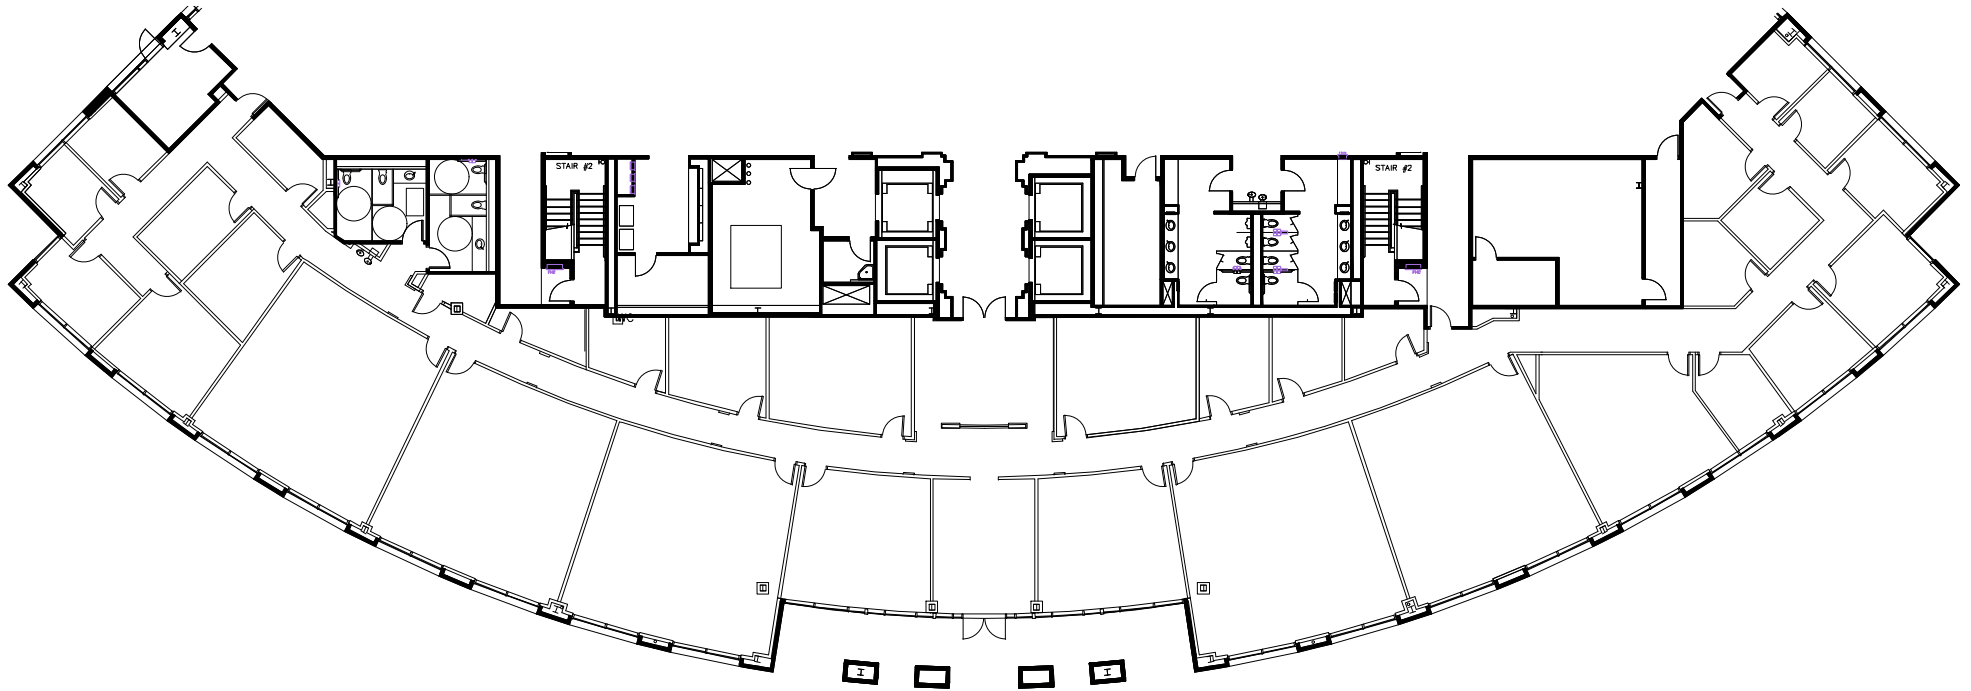


SUITE 150
AS BUILT - 1 OF 1
HARRIS BUILDING - LEVEL ONE
11,876 USF/ 13,776 RSF
NOT TO SCALE
DATE: JANUARY 22, 2019

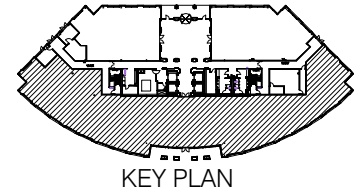

NORTHWOOD
OFFICE

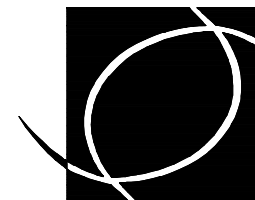

**SMITH
HARRIS**
DESIGN
associates