



SUITE 550  
AS BUILT - 1 OF 1  
HARRIS BUILDING - LEVEL FIVE  
9,057 RSF  
SCALE: 1/16" = 1'-0"  
DATE: JANUARY 23, 2019

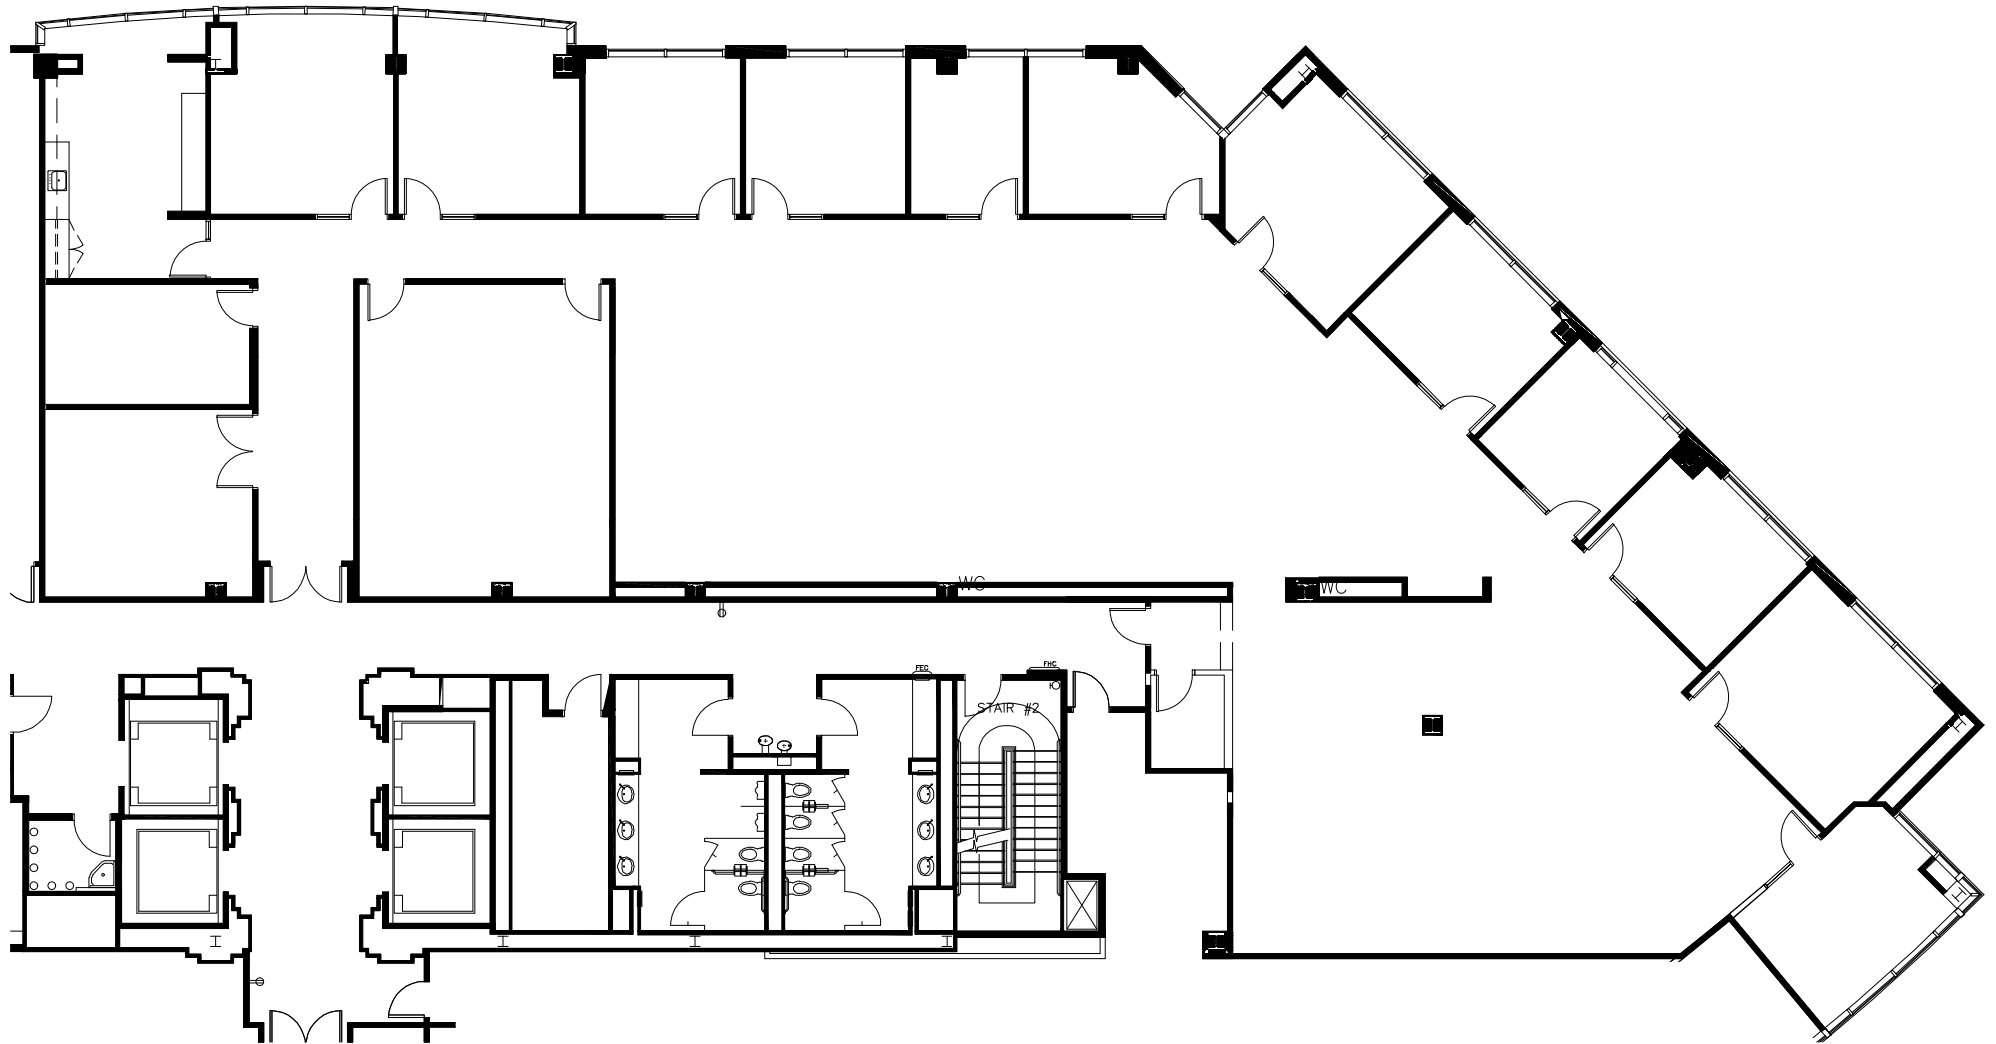

**NORTHWOOD**  
OFFICE

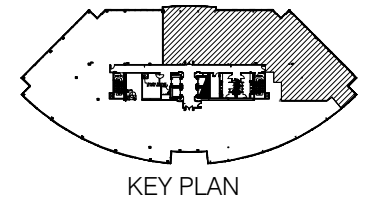

**SMITH  
HARRIS**  
**DESIGN**  
associates