



SUITE 250
AS BUILT - 1 OF 1
13900 CONLAN CIRCLE - LEVEL TWO
7,313 USF / 8,410 RSF
NOT TO SCALE
DATE: APRIL 12, 2017

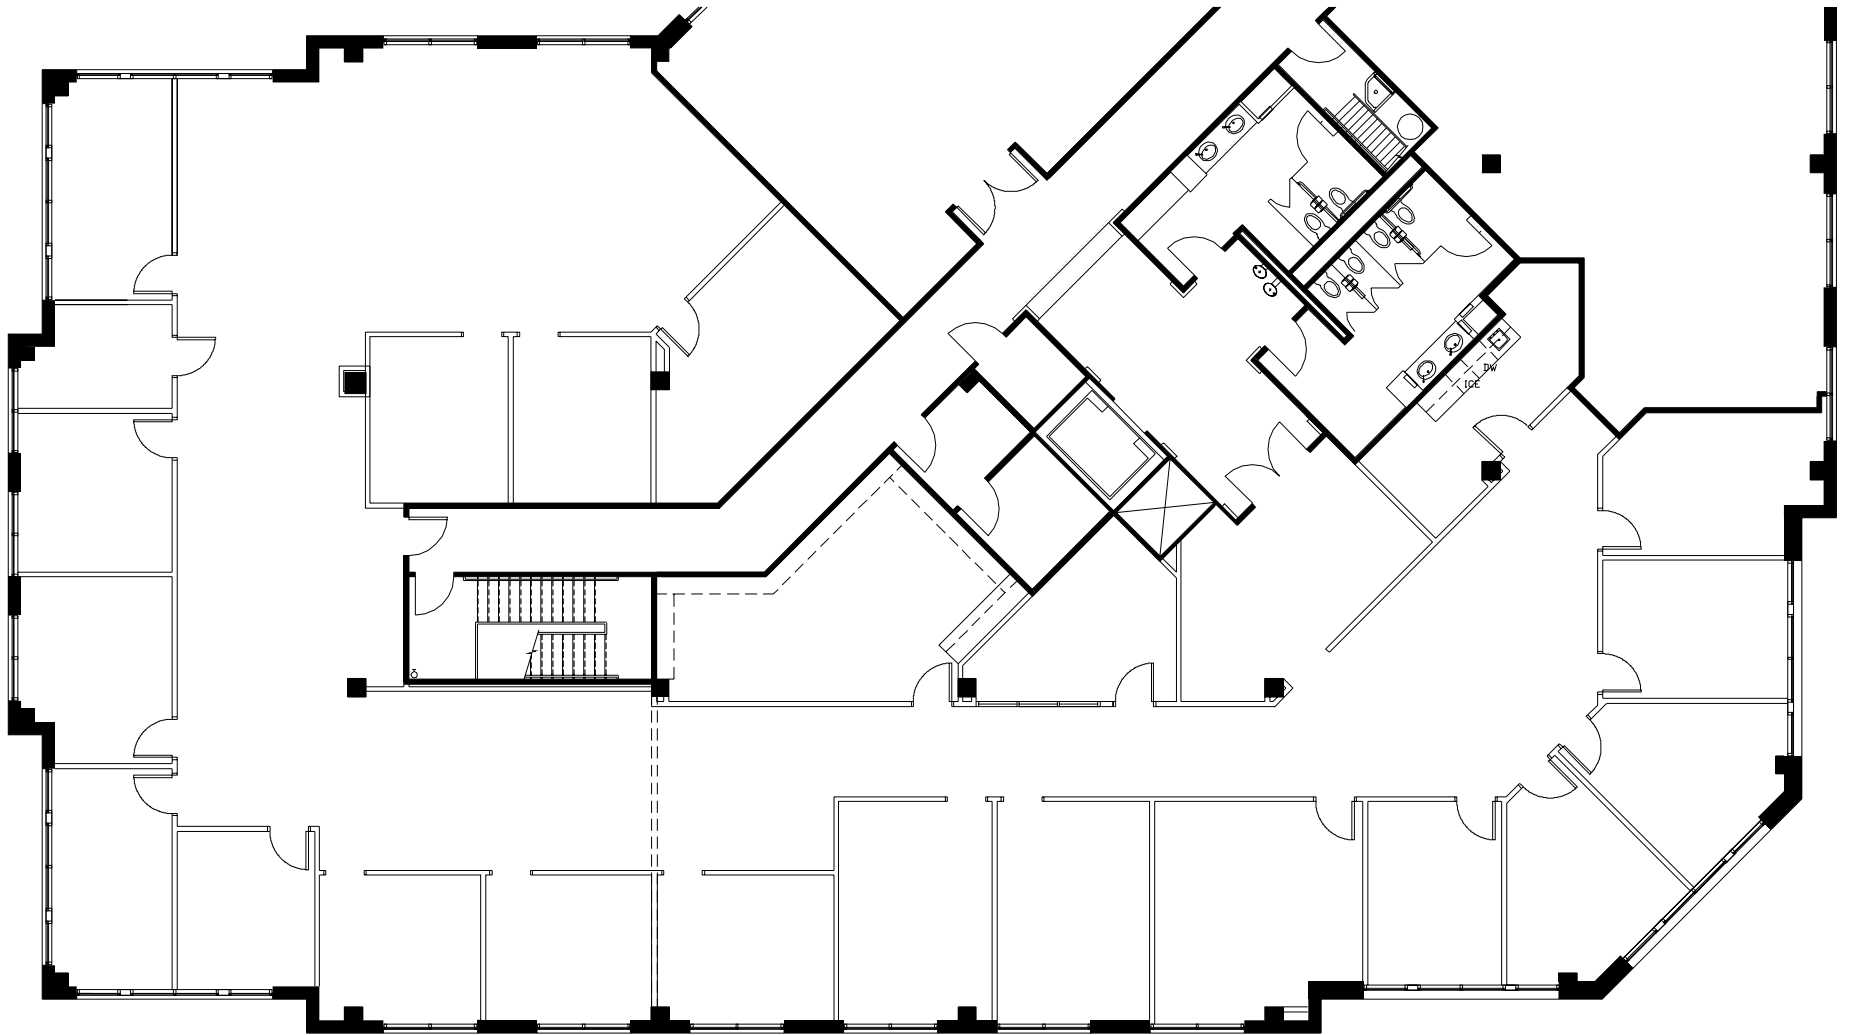

KEY PLAN



NORTHWOOD
OFFICE

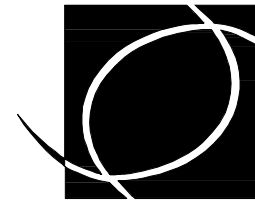

**SMITH
HARRIS**
DESIGN
associates