


SUITES 225
AS BUILT - 1 OF 1
HARRIS BUILDING - LEVEL TWO
9,079 USF / 10,532 RSF
NOT TO SCALE
DATE: MAY 8, 2019

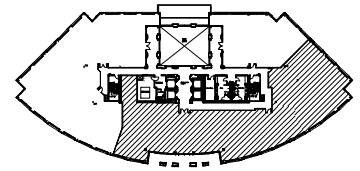

KEY PLAN

