





SUITE 625  
AS BUILT - 1 OF 1  
HARRIS BUILDING - LEVEL SIX  
3,673 RSF  
SCALE: 3/32" = 1'-0"  
DATE: DECEMBER 12, 2018

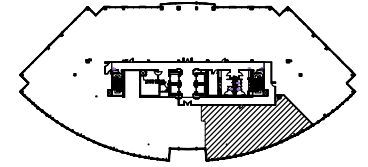

KEY PLAN

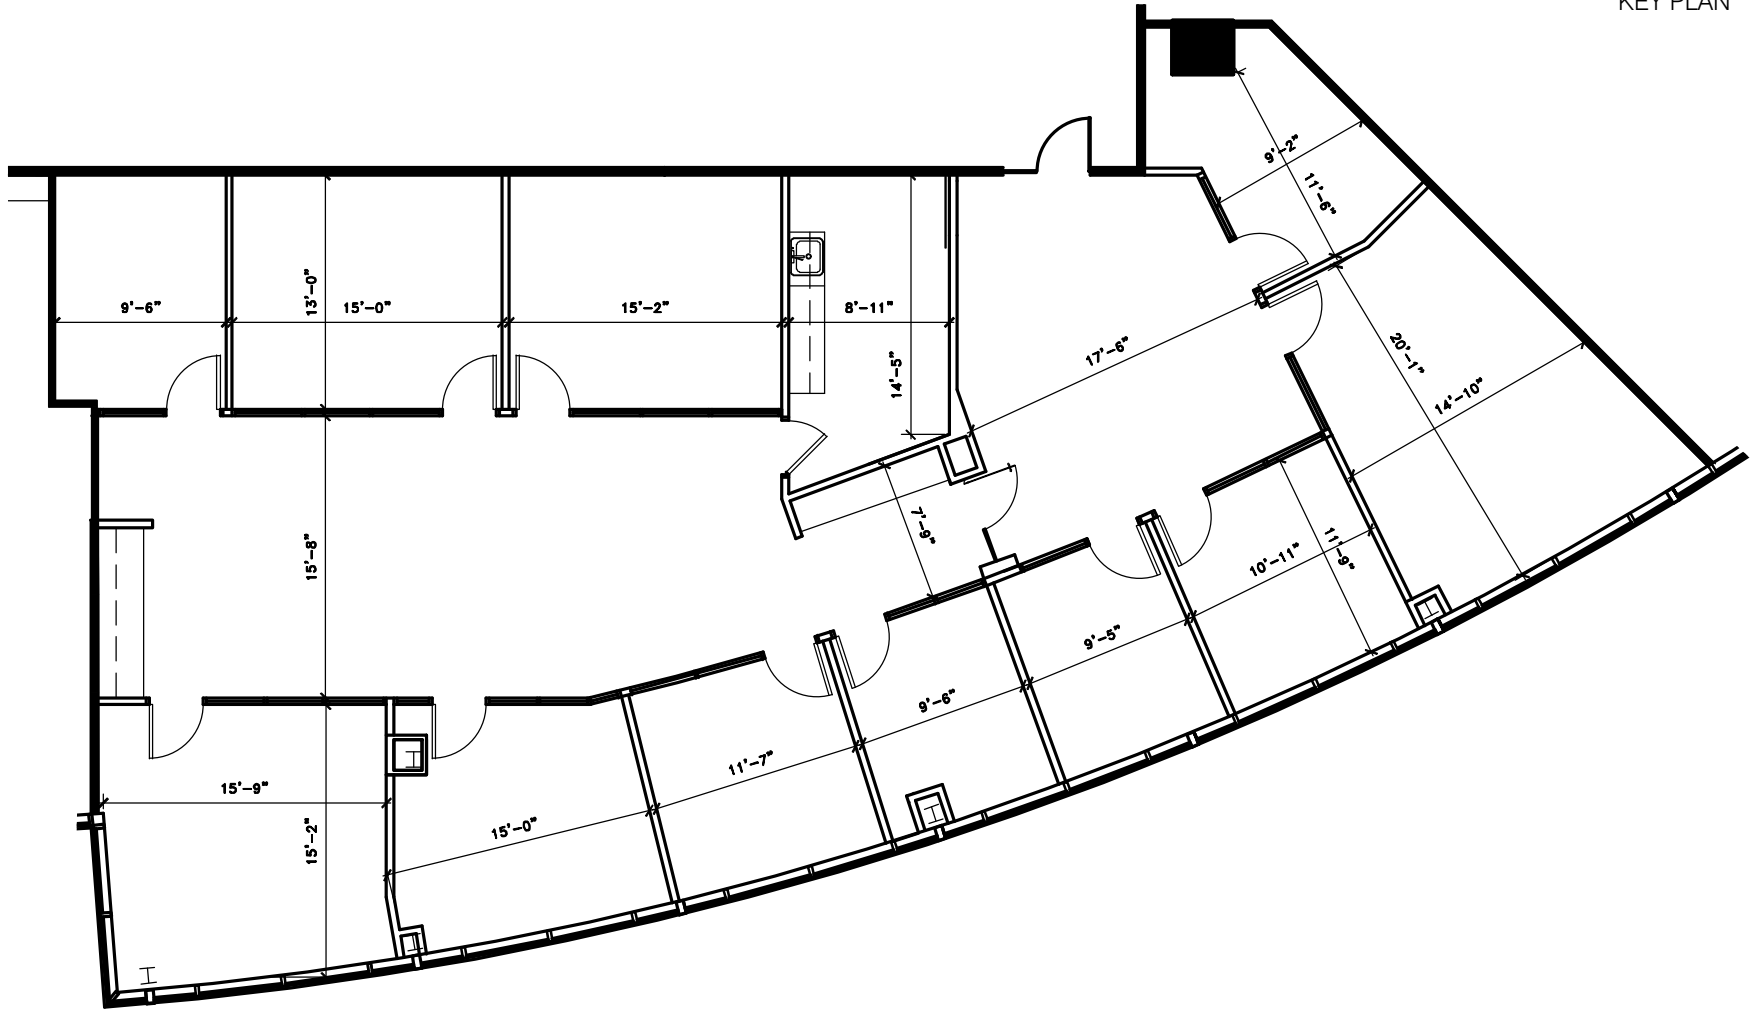

**NORTHWOOD**  
OFFICE

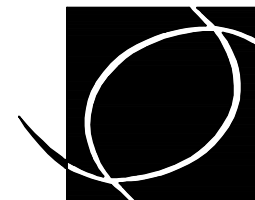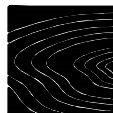

**SMITH  
HARRIS**  
**DESIGN**  
associates