


SUITES 225
 AS BUILT - 1 OF 1
 HARRIS BUILDING - LEVEL TWO
 9,797 USF / 11,365 RSF
 NOT TO SCALE
 DATE: JULY 9, 2021

SUMMARY

- 1 RECEPTION
- 4 CONFERENCE
- 2 BREAK ROOM
- 3 COPY/WORK AREAS
- 1 IT ROOM
- 12 PRIVATE OFFICE
- 8 ADMIN AREAS
- 2 OPEN AREAS
- 4 STORAGE ROOMS

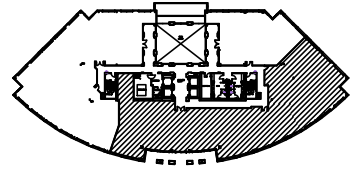

KEY PLAN

