



SUITE 150
AS BUILT - 1 OF 1
CORPORATE VILLA D - LEVEL ONE
700 RSF
SCALE: 1/8" = 1'-0"
DATE: MARCH 14, 2019

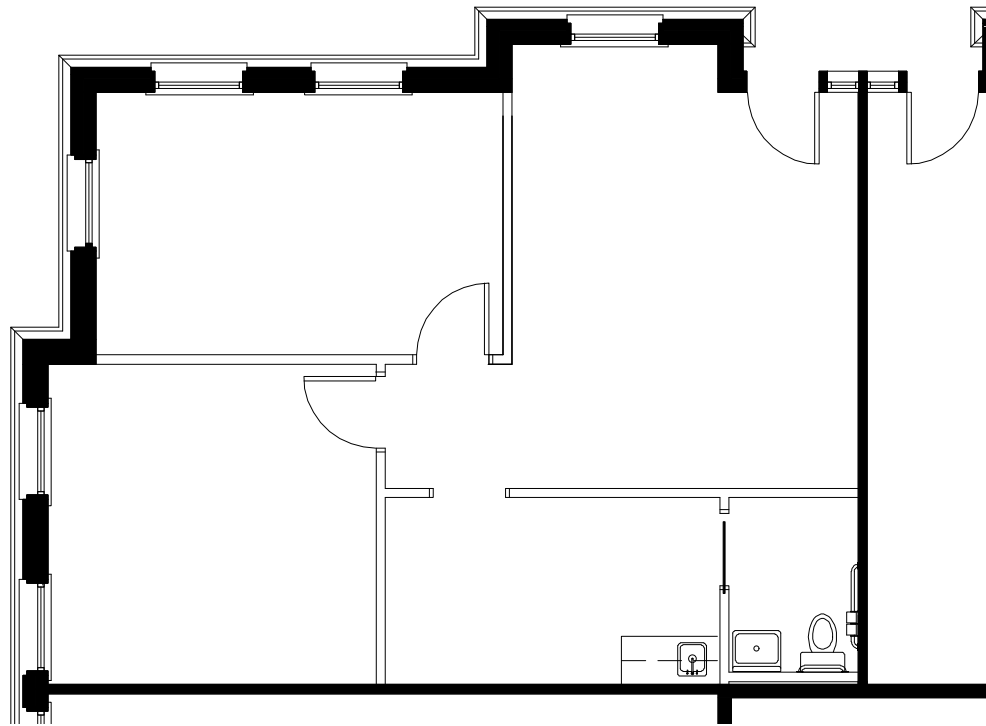

NORTHWOOD
OFFICE

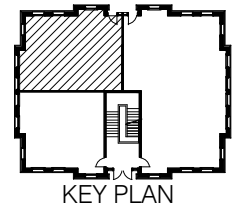

**SMITH
HARRIS**
DESIGN
associates