



SUITE 500
AS BUILT - 1 OF 1
BRIXHAM GREEN ONE - LEVEL FIVE
5,461 USF / 6,335 RSF
NOT TO SCALE
DATE: APRIL 23, 2019

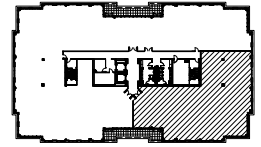

KEY PLAN

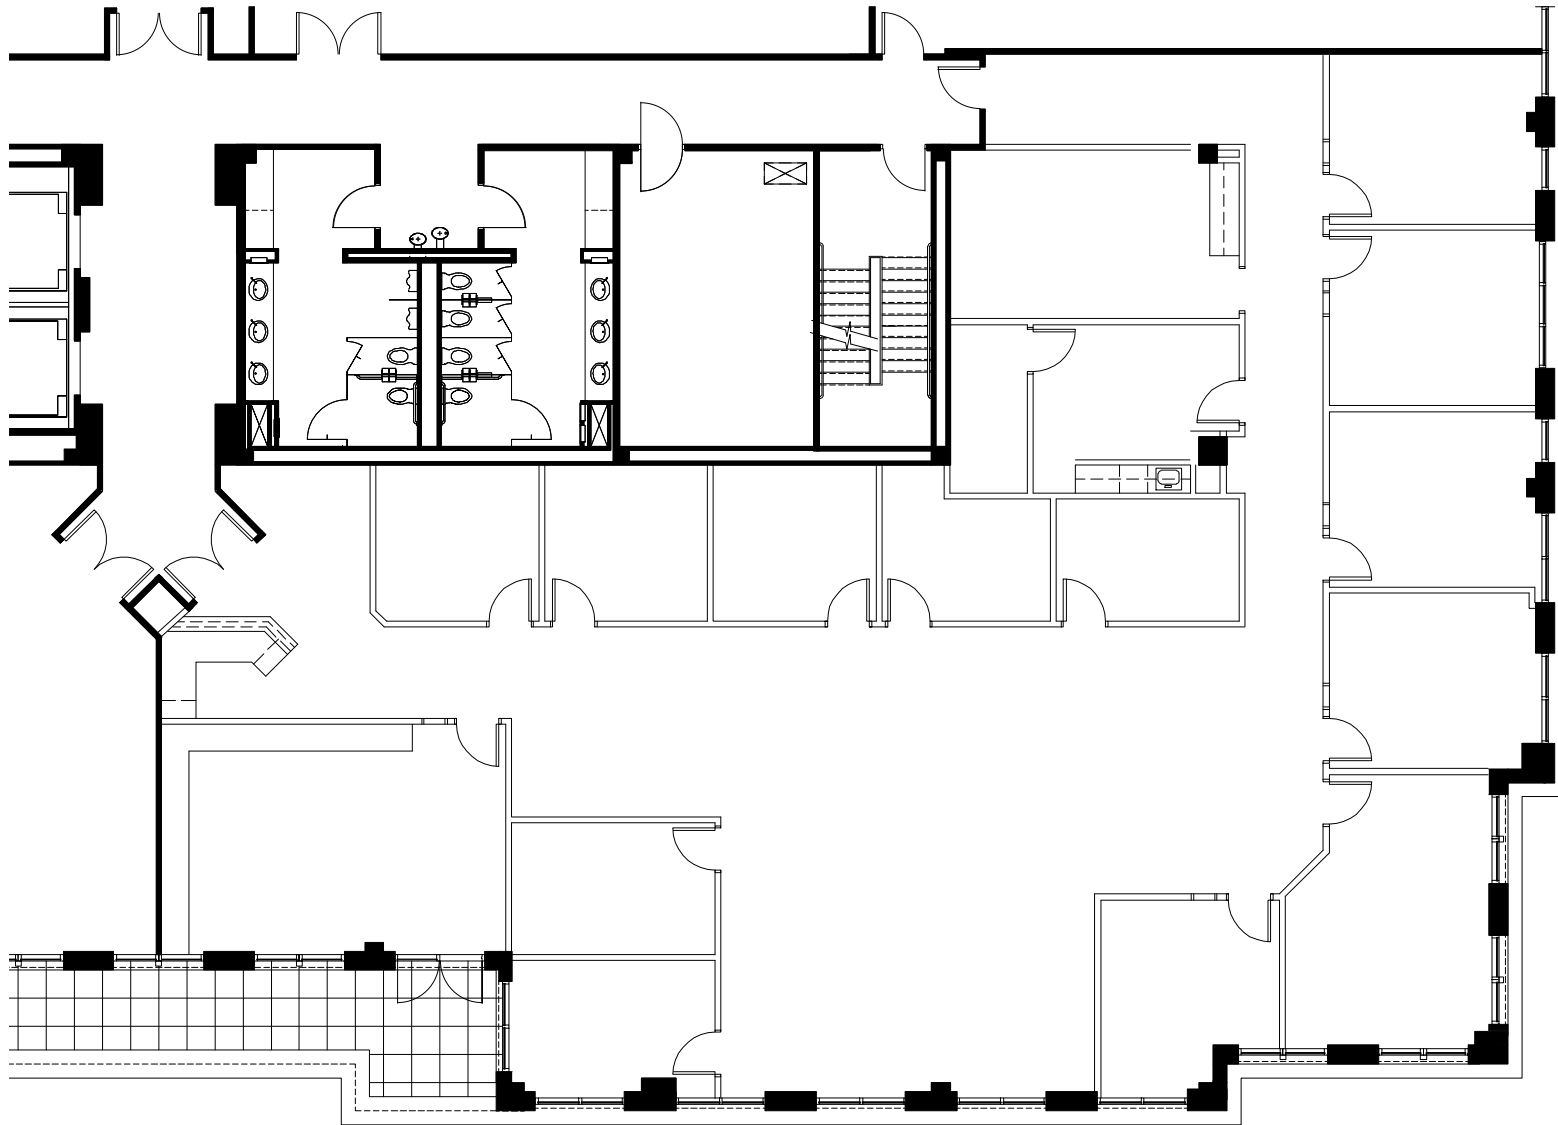

NORTHWOOD
OFFICE 



**SMITH
HARRIS**
DESIGN
associates