


SUITE 100
3,090 USF

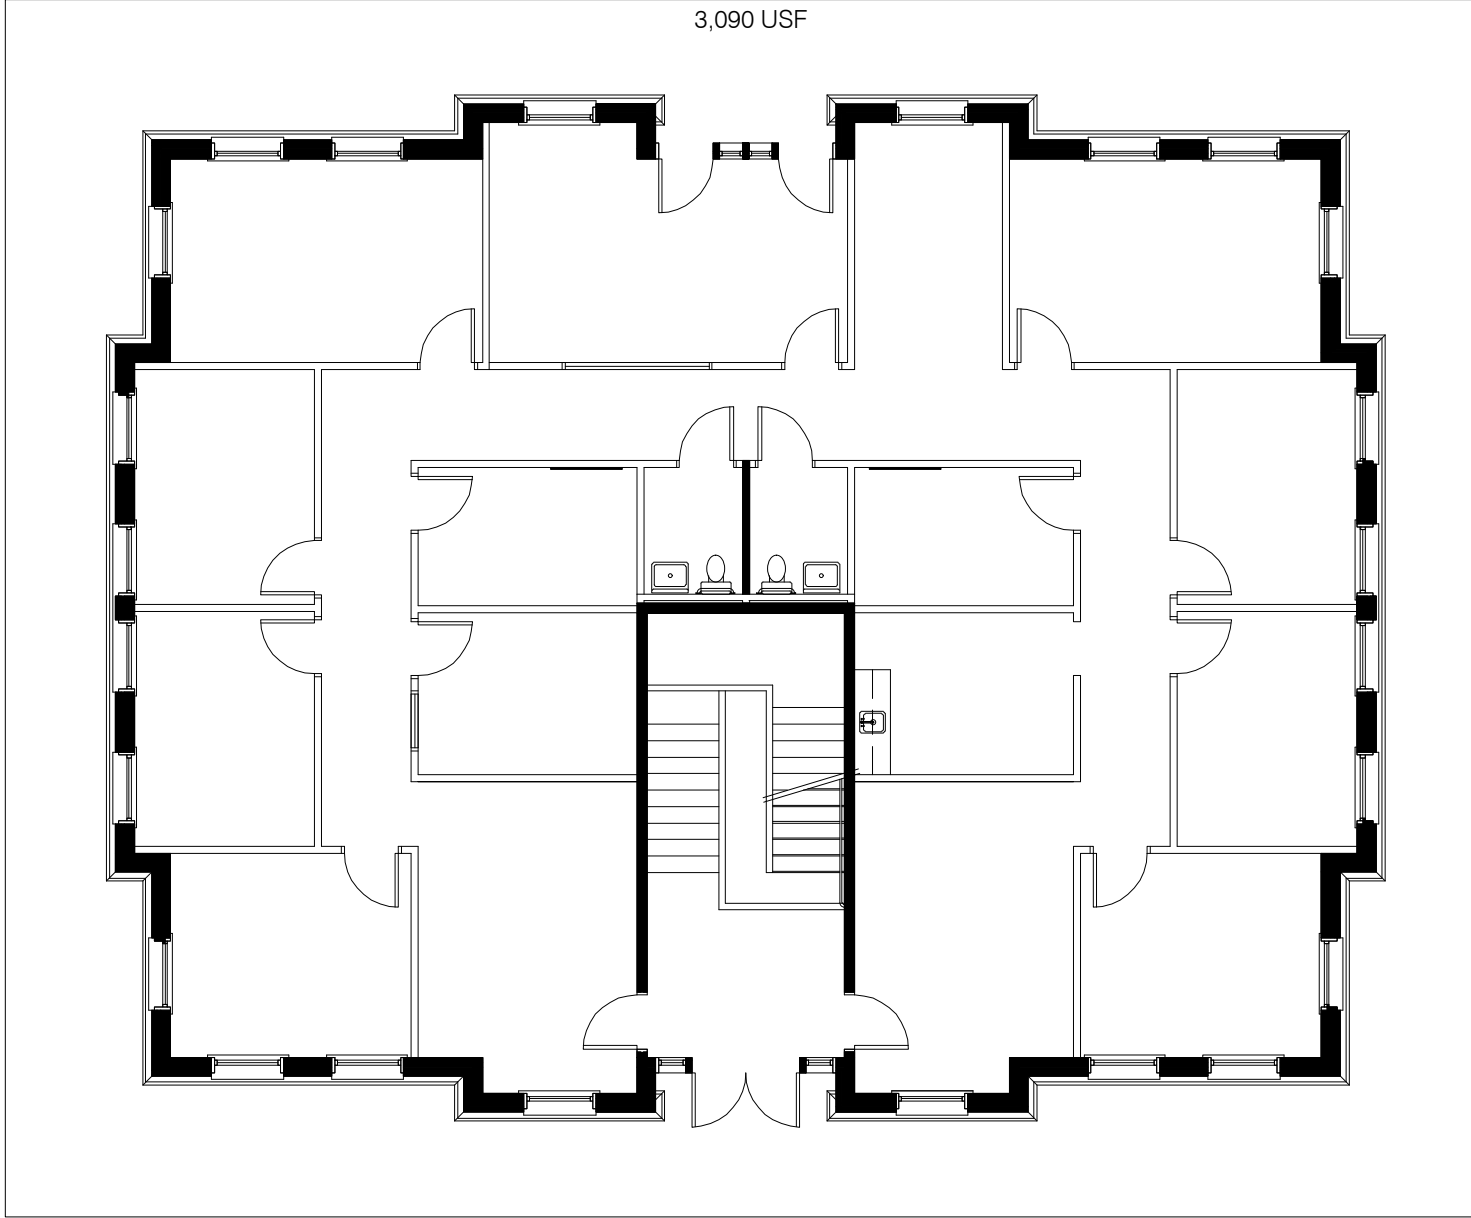

Offices On Six

North Community
House Road

Building E

Level
One

As Built

April 22, 2019

Not to Scale

NORTHWOOD
OFFICE



**SMITH
HARRIS**
DESIGN
associates