



SUITE 275  
AS BUILT - 1 OF 1  
FRENETTE BUILDING - LEVEL TWO  
8,186 USF / 9,496 RSF  
SCALE: 1/16" = 1'-0"  
DATE: MARCH 25, 2019

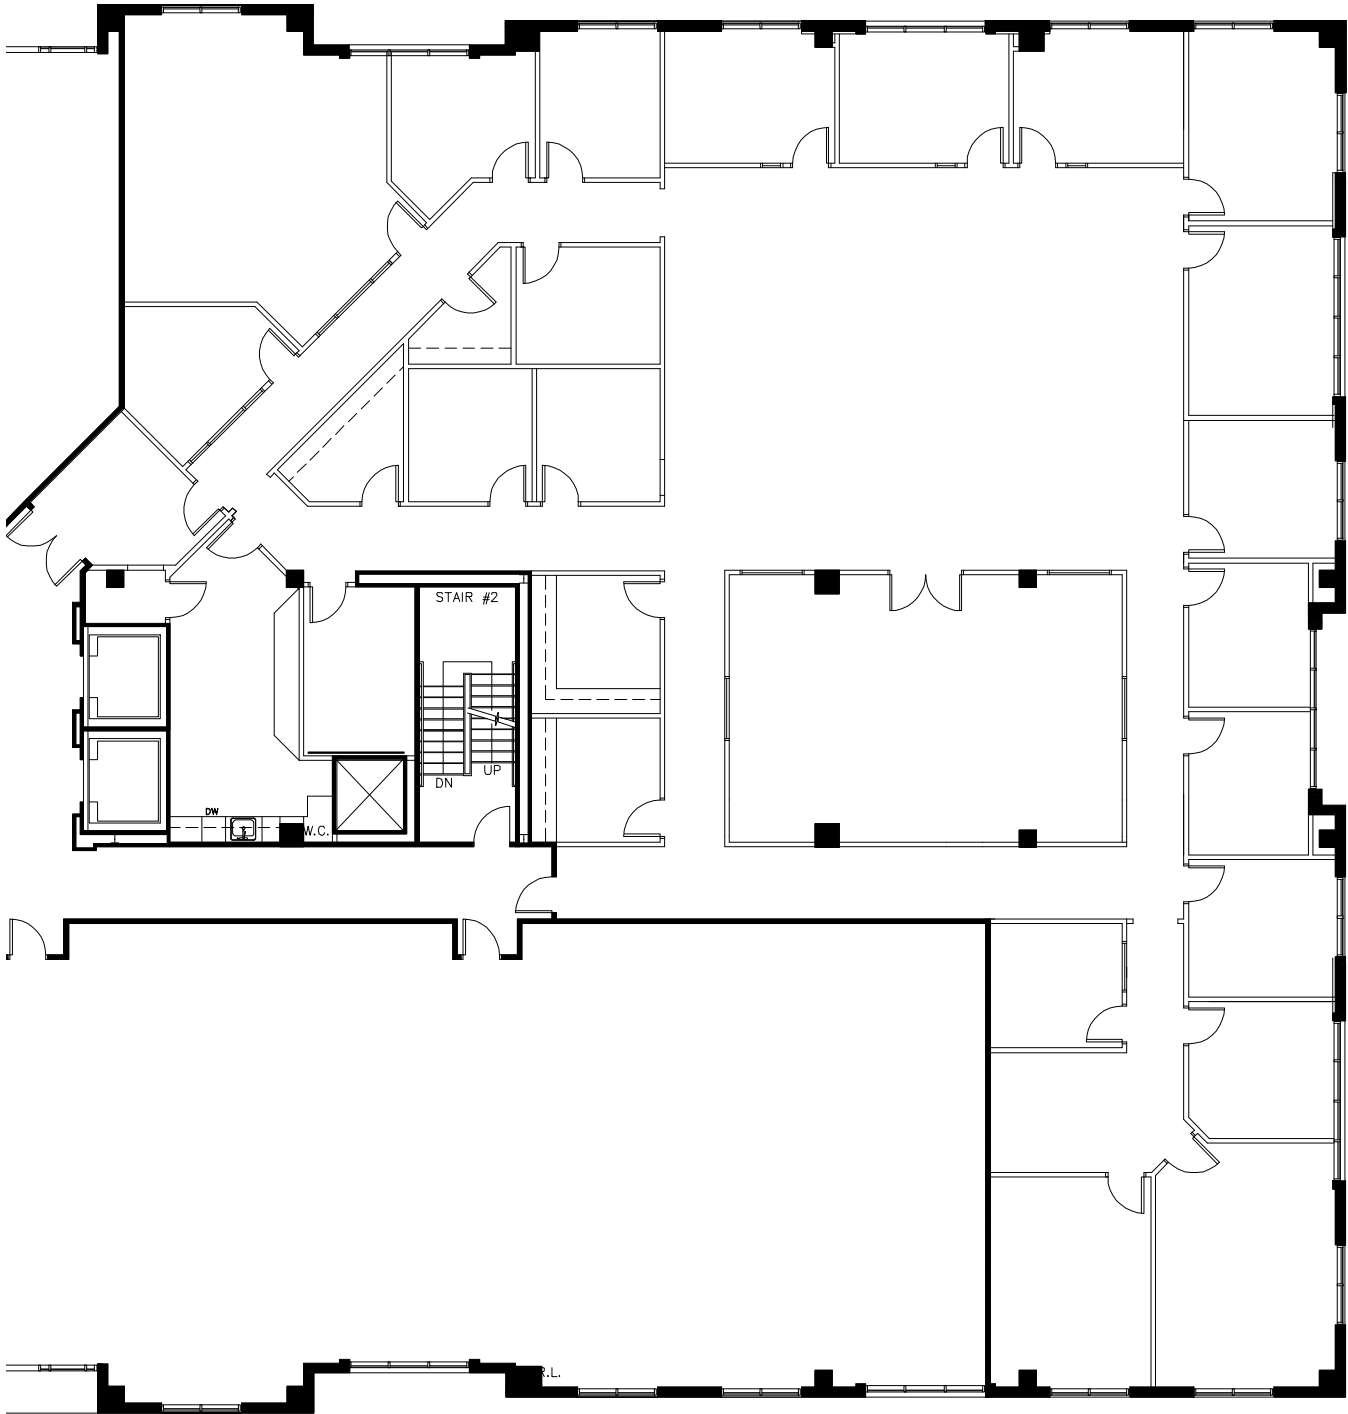

KEY PLAN



**NORTHWOOD**  
OFFICE

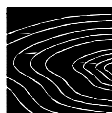

**SMITH  
HARRIS**  
DESIGN  
associates