



SUITE 275
AS BUILT - 1 OF 1
FRENETTE BUILDING - LEVEL TWO
8,186 USF / 9,496 RSF
SCALE: 1/16" = 1'-0"
DATE: NOVEMBER 20, 2019

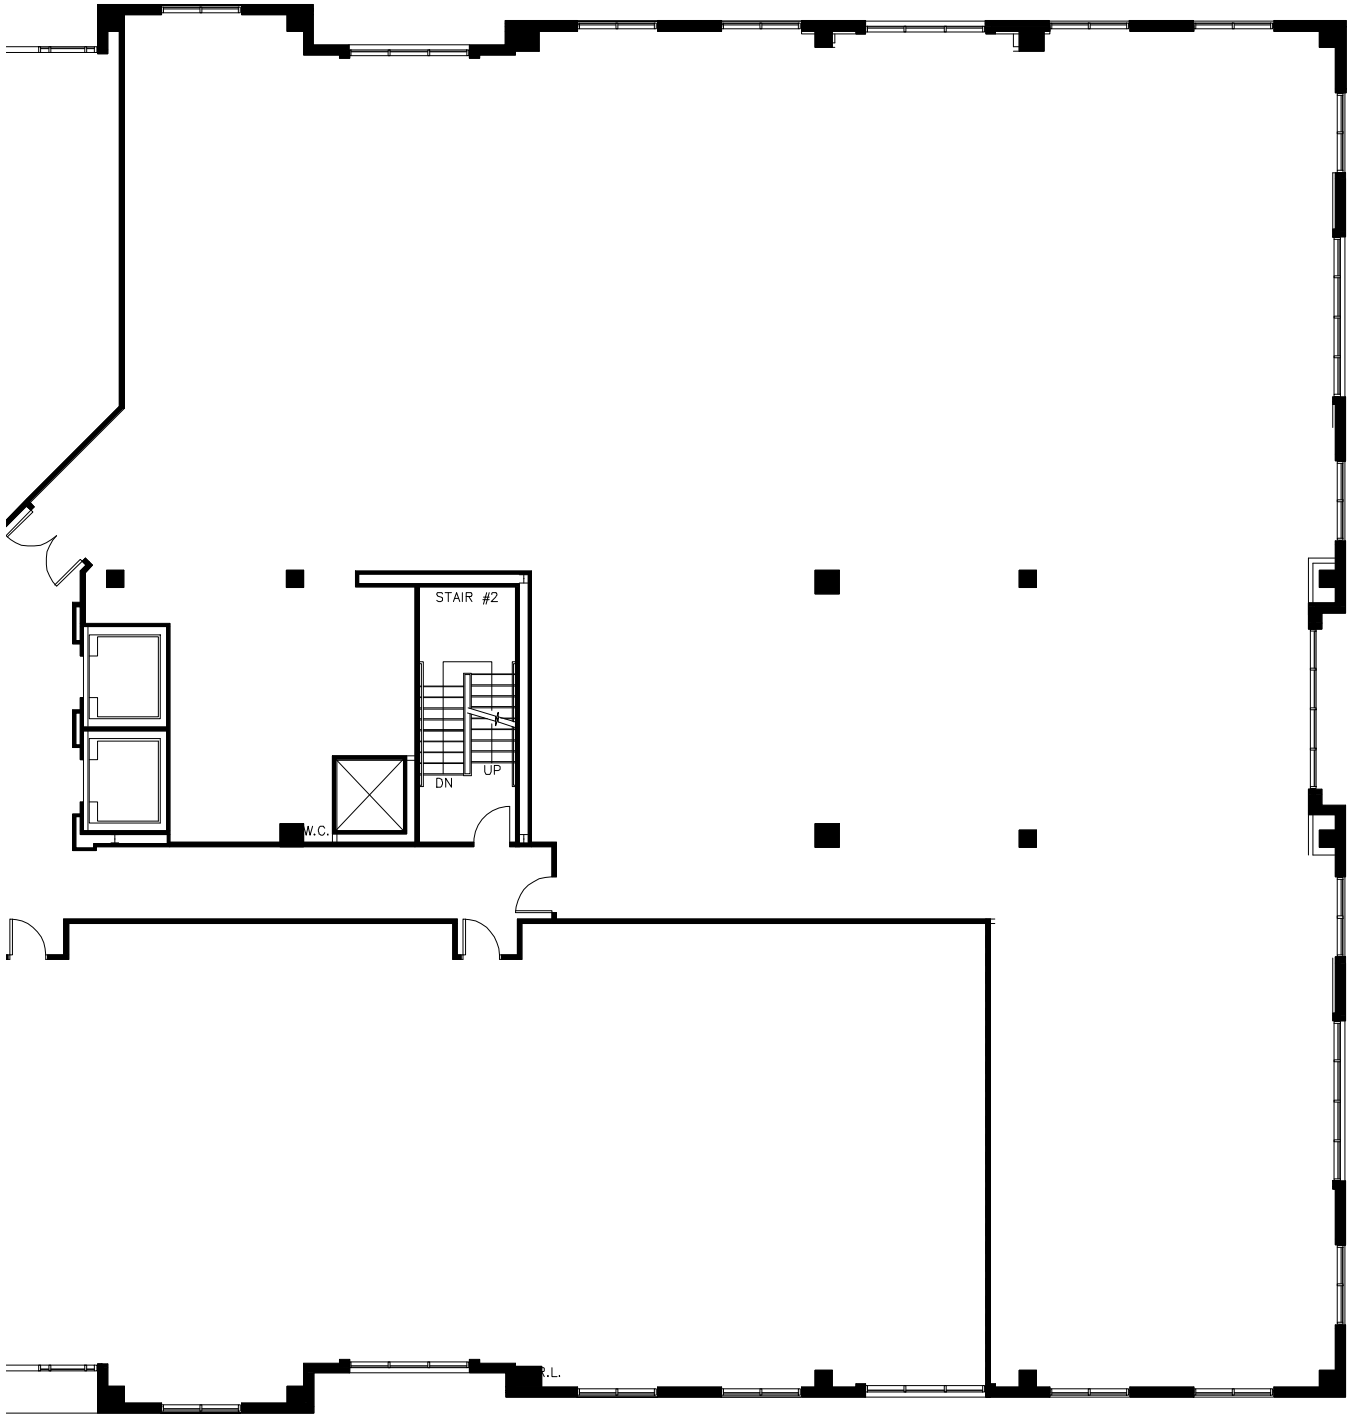

KEY PLAN



NORTHWOOD
OFFICE

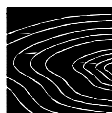

**SMITH
HARRIS**
DESIGN
associates