


SUITE 100
AS BUILT - 1 OF 1
CORPORATE VILLA E - LEVEL ONE
3,200 RSF
NOT TO SCALE
DATE: FEBRUARY 9, 2021

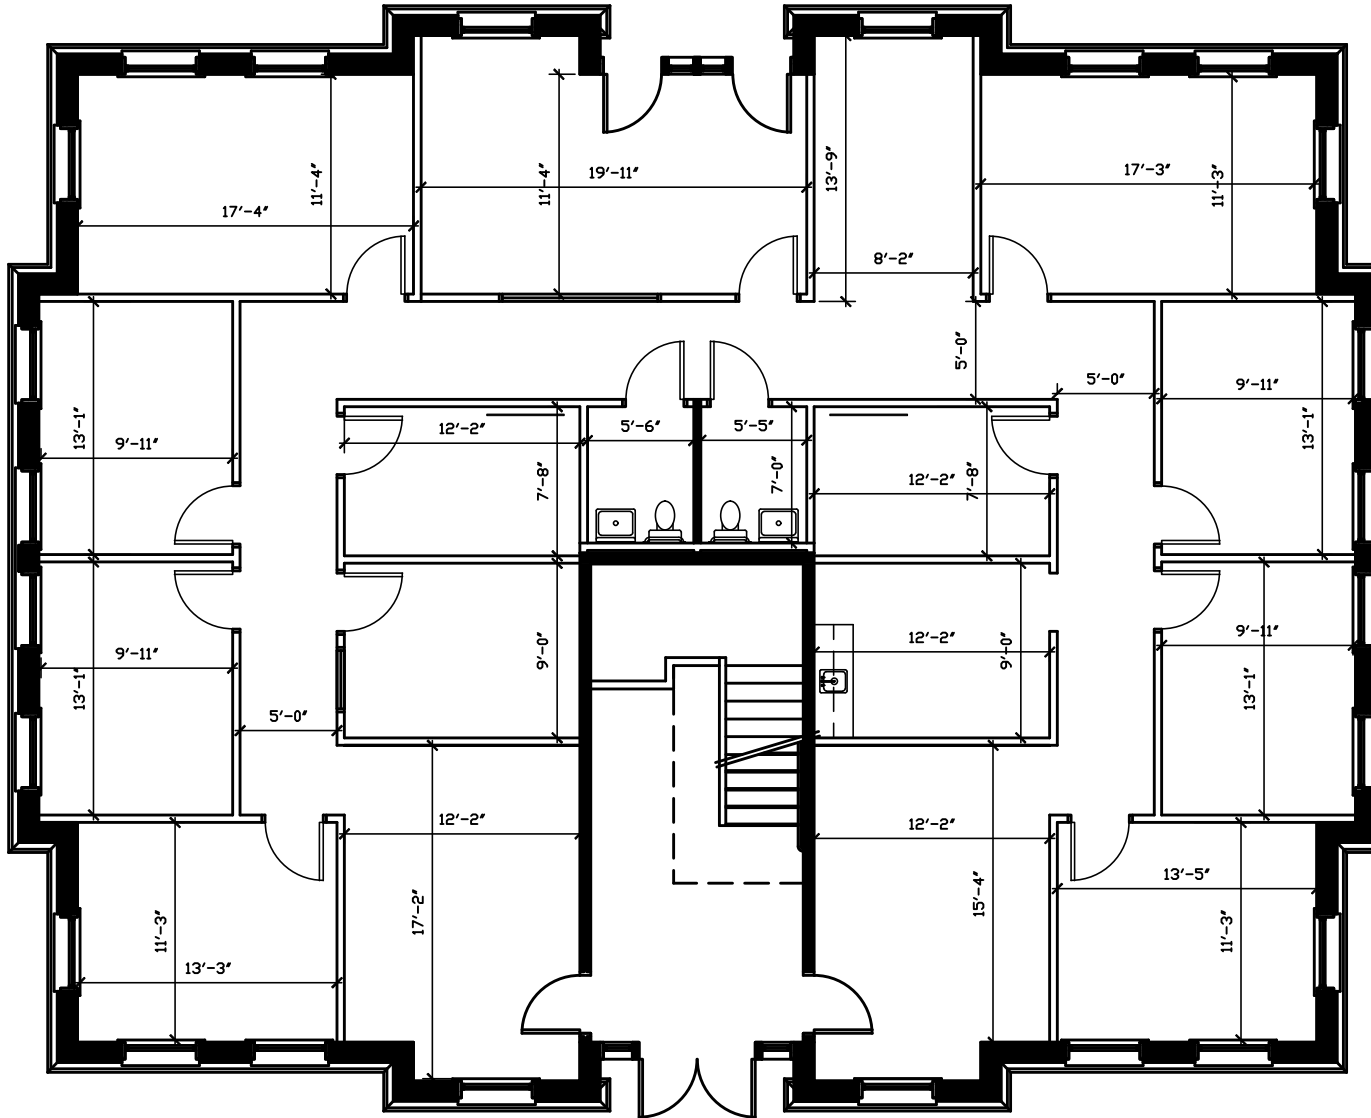

SUMMARY	
1	RECEPTION
9	PRIVATE OFFICE
2	IT/STORAGE
2	RESTROOMS
1	CONFERENCE
2	OPEN AREAS
1	BREAK