





SUITE 325
AS BUILT - 1 OF 1
CULLMAN PARK - LEVEL THREE
2,171 USF / 2,518 RSF
SCALE: 1/8" = 1'-0"
DATE: JUNE 17, 2019

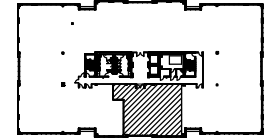

KEY PLAN

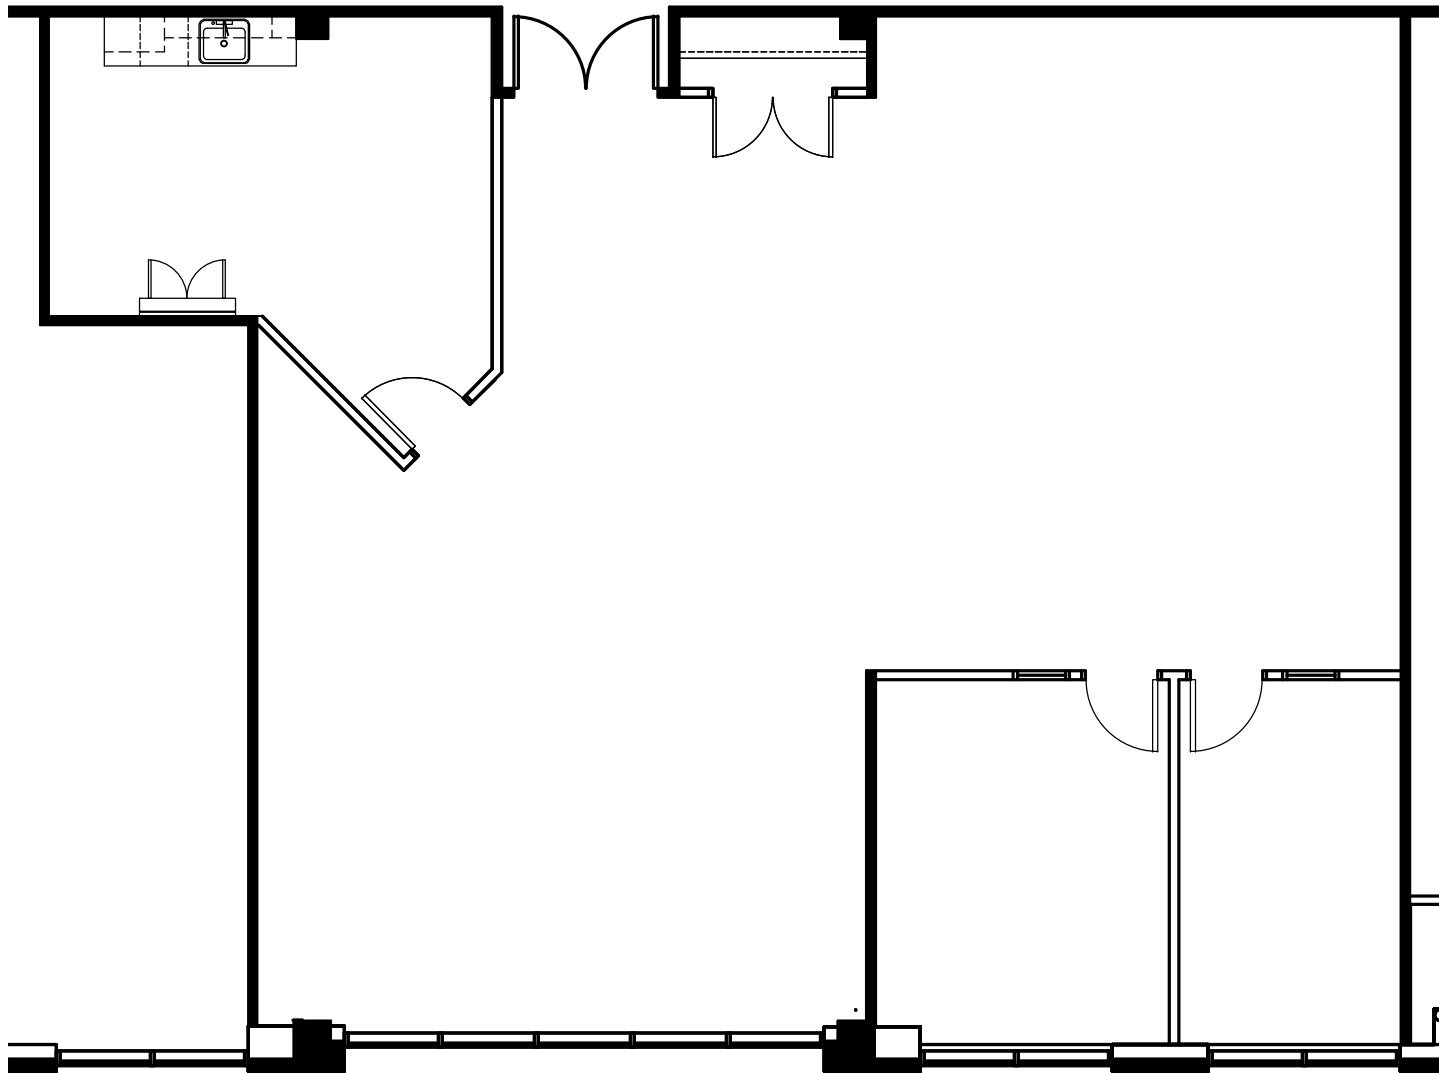

NORTHWOOD
OFFICE

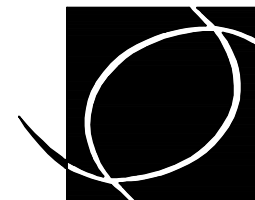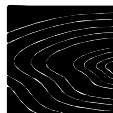

**SMITH
HARRIS**
DESIGN
associates