



SUITE 550
AS BUILT - 1 OF 1
IRBY BUILDING - LEVEL FIVE
3,952 USF / 4,584 RSF
NOT TO SCALE
DATE: JUNE 5, 2019

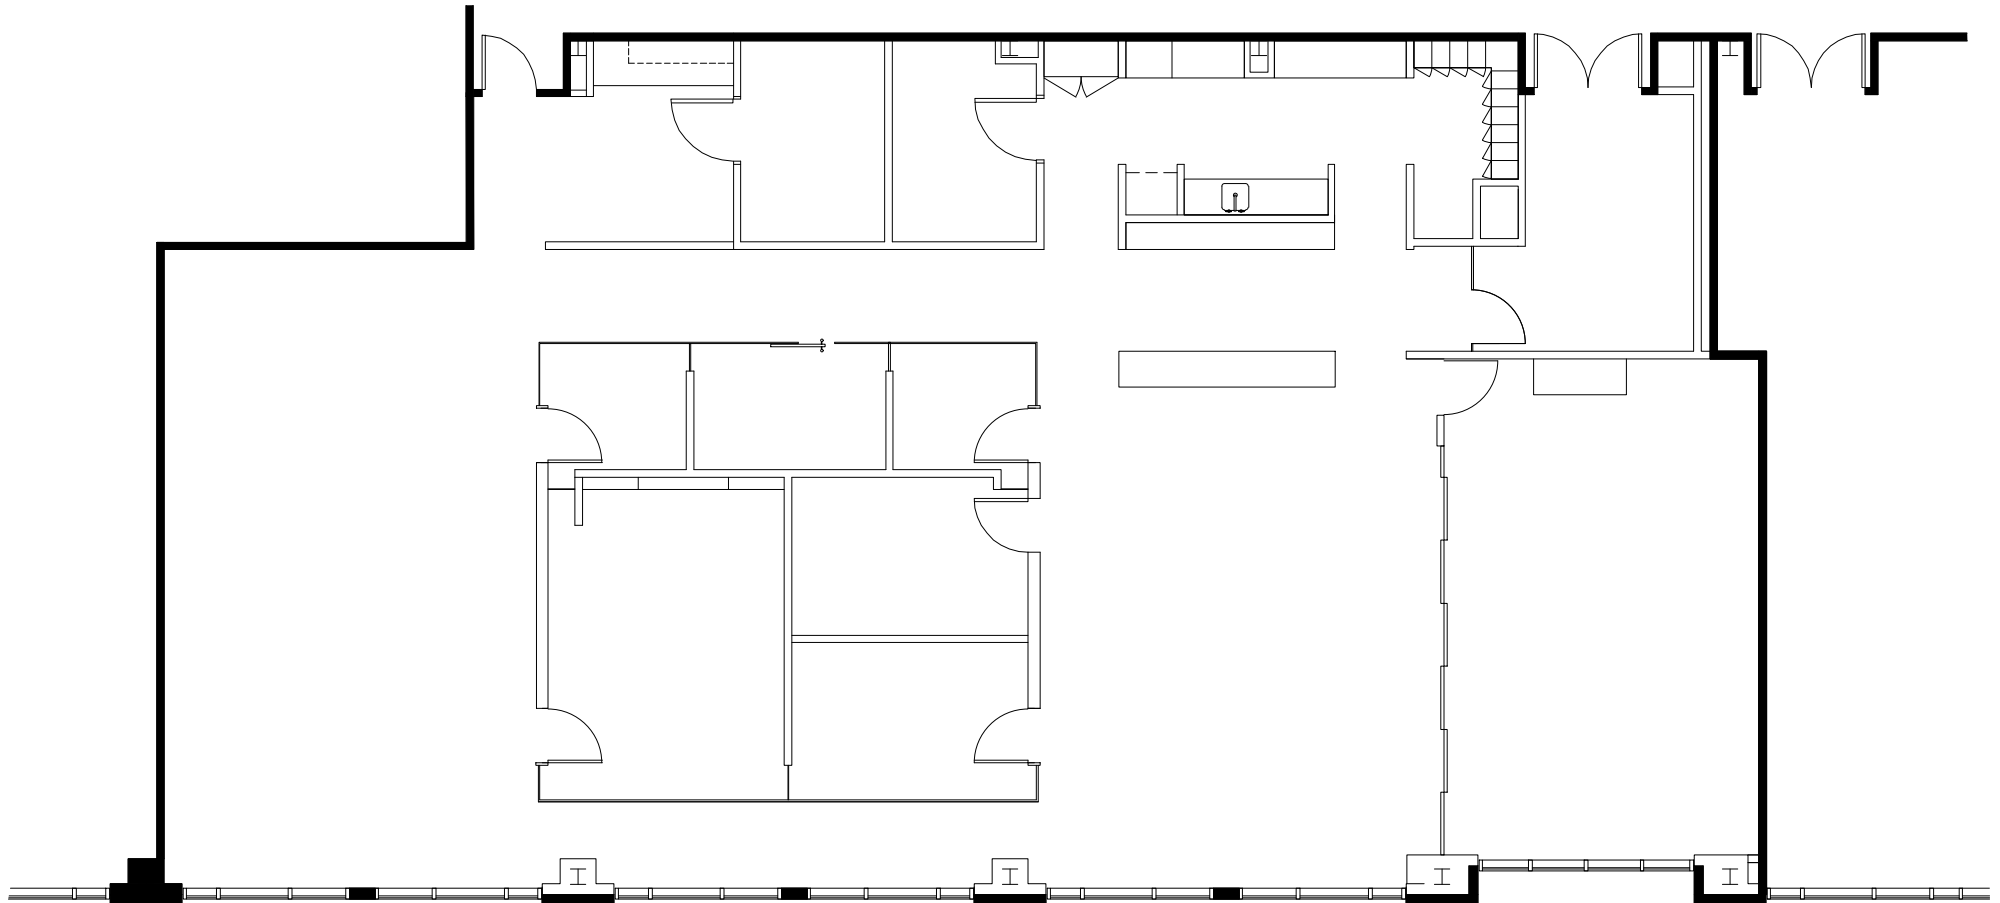

NORTHWOOD
OFFICE

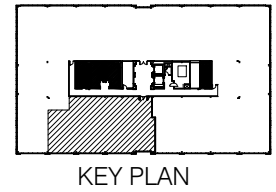

**SMITH
HARRIS**
DESIGN
associates