





SUITE 100
AS BUILT - 1 OF 1
ALLEN TATE - LEVEL ONE
3,179 RSF (TOTAL)
SCALE: 3/32" = 1'-0"
DATE: SEPTEMBER 20, 2018

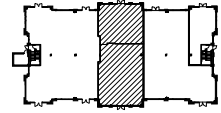

KEY PLAN

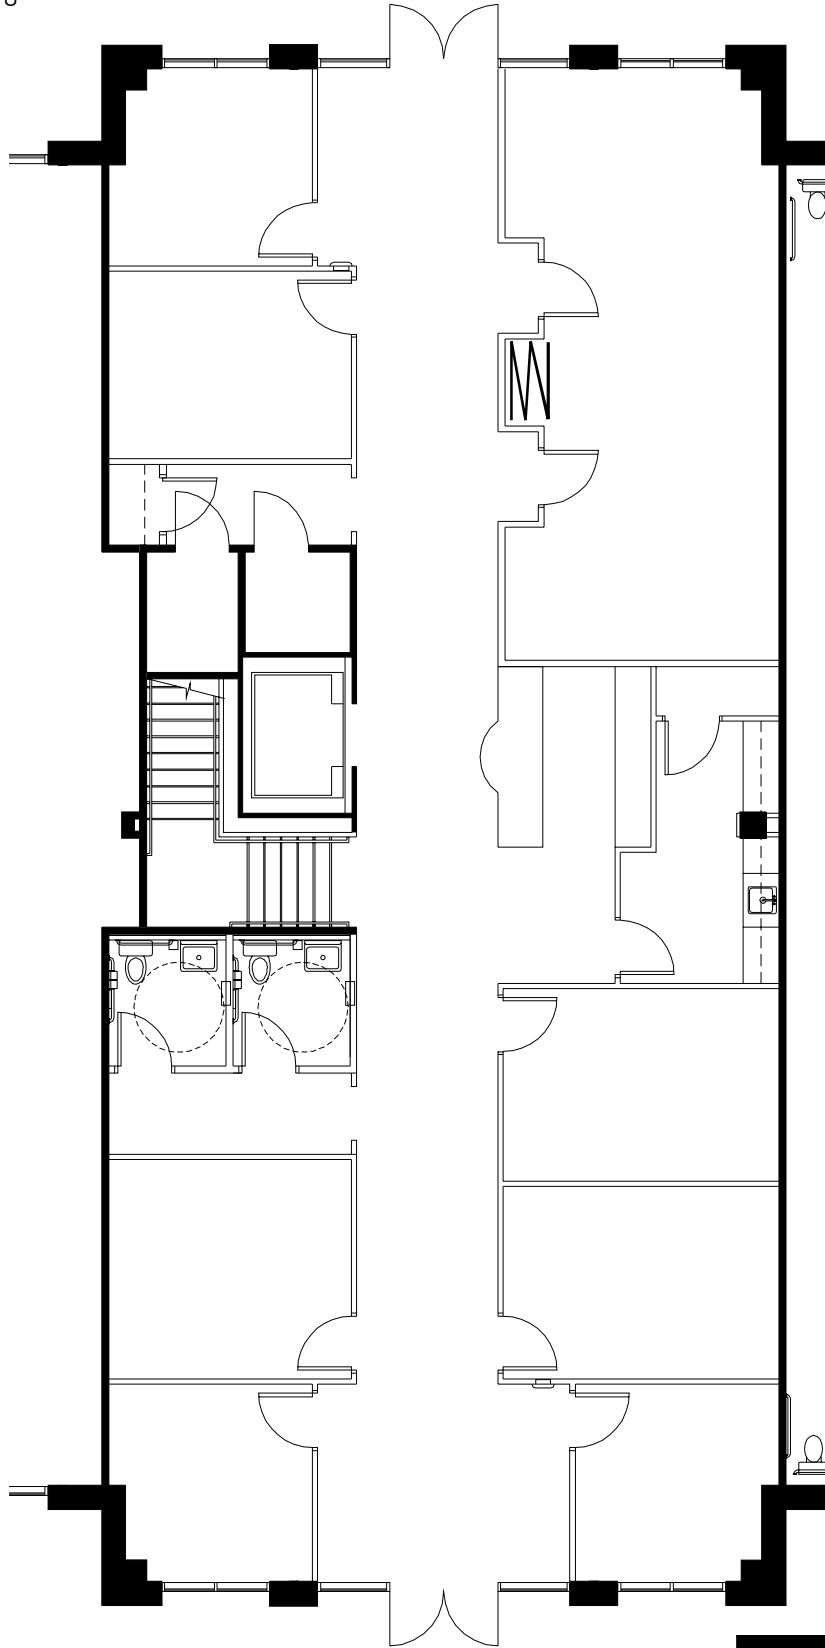

NORTHWOOD
OFFICE

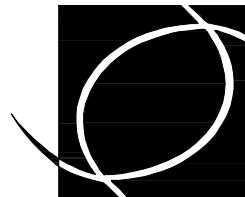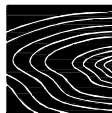

**SMITH
HARRIS**
DESIGN
associates