


# Allen Tate Building

SUITE 200  
12,273 RSF

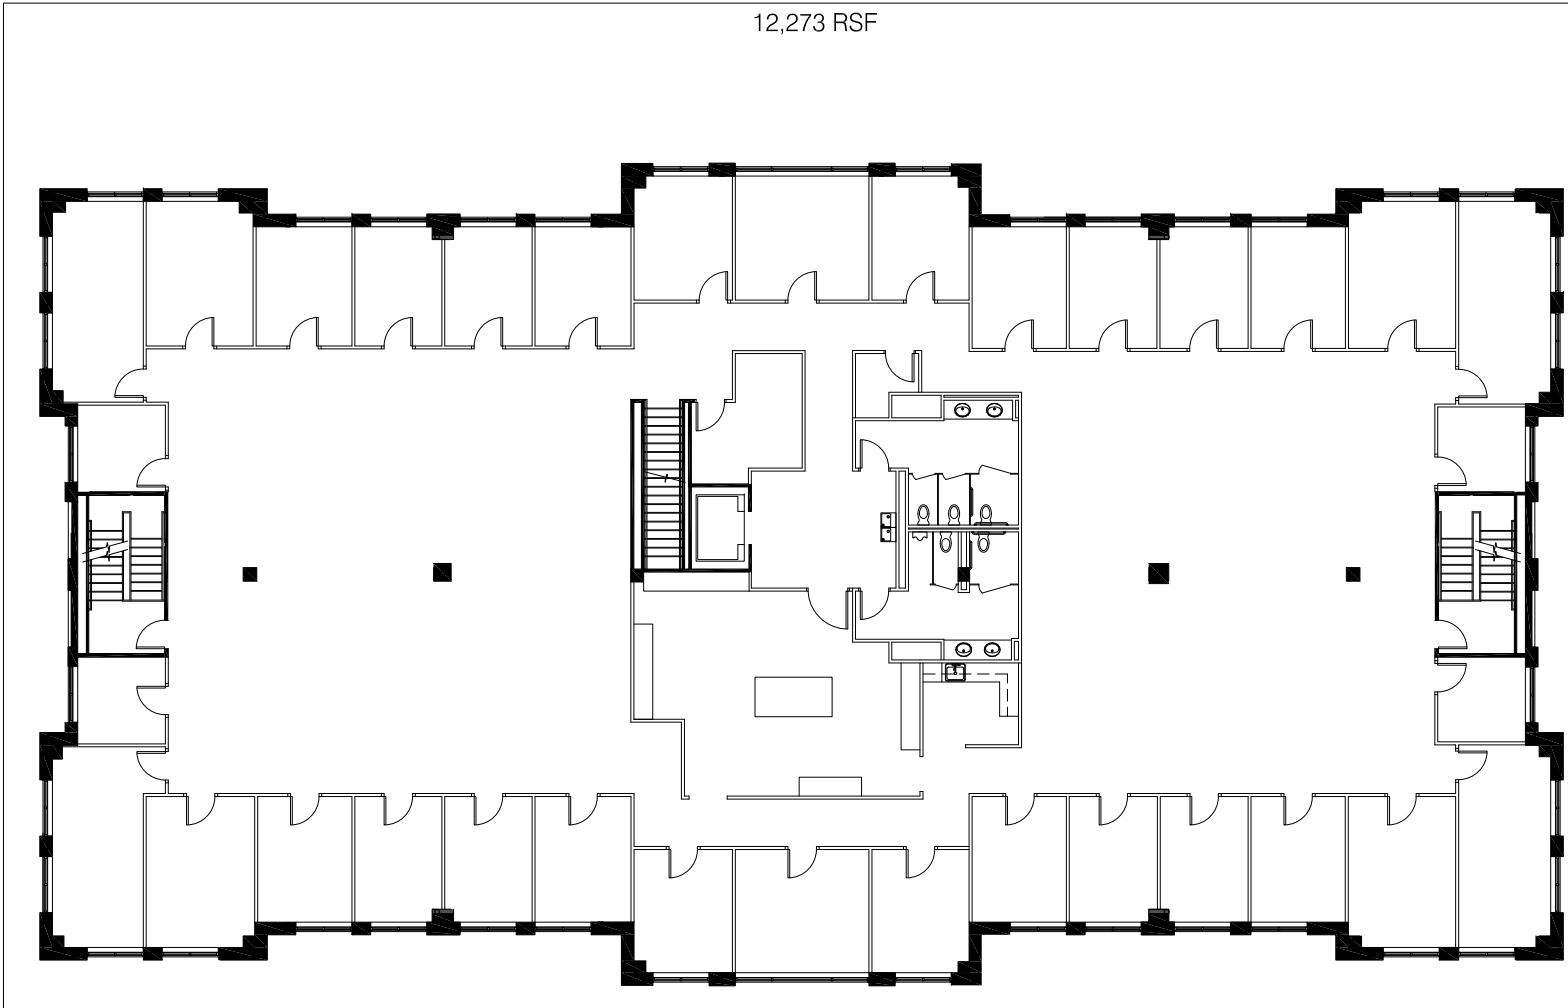

15640 Don  
Lochman Ln

Level  
Two

As Built

August 14, 2018

Not to Scale

**NORTHWOOD**  
OFFICE

