


Allen Tate Building

SUITE 100
3,179 RSF

SUITE 200
12,273 RSF

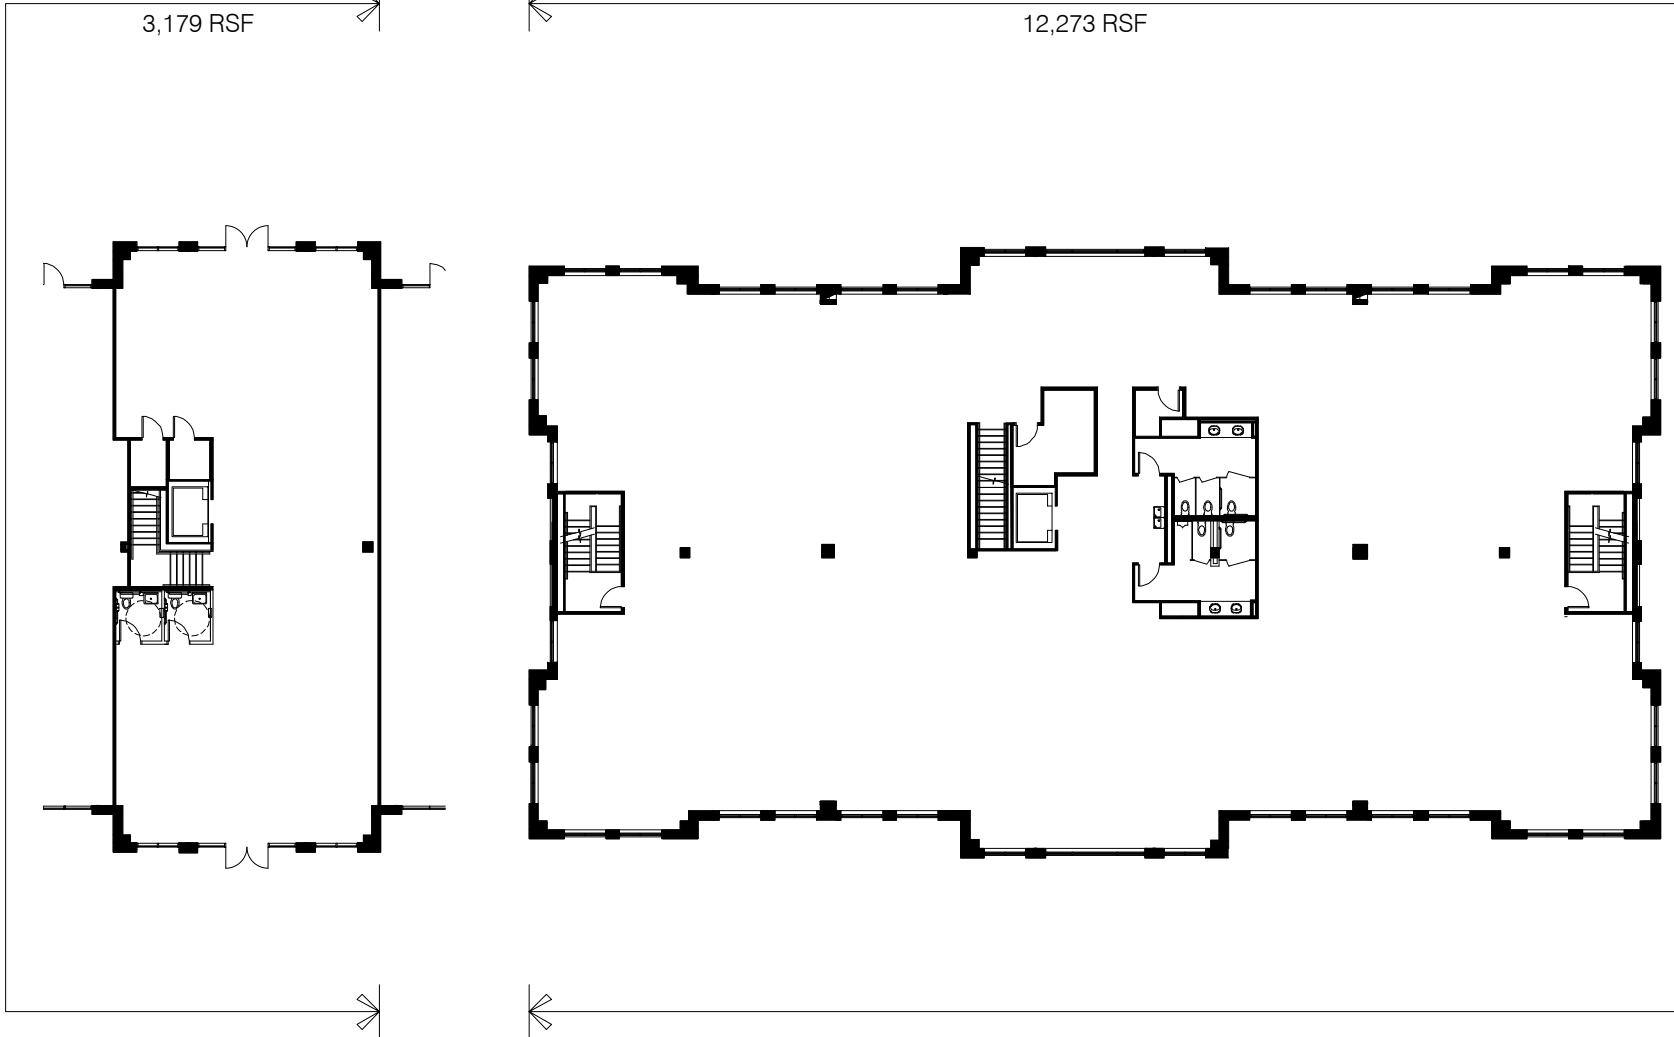

15640 Don
Lochman Ln

Level
One & Two

As Built

Nov. 13, 2019

Not to Scale

15,452 TOTAL RSF

NORTHWOOD
OFFICE



**SMITH
HARRIS**
DESIGN
associates