




SUITE 675
AS BUILT - 1 OF 1
HARRIS BUILDING - LEVEL SIX
6,942 USF / 8,053 RSF
NOT TO SCALE
DATE: JUNE 10, 2019



KEY PLAN

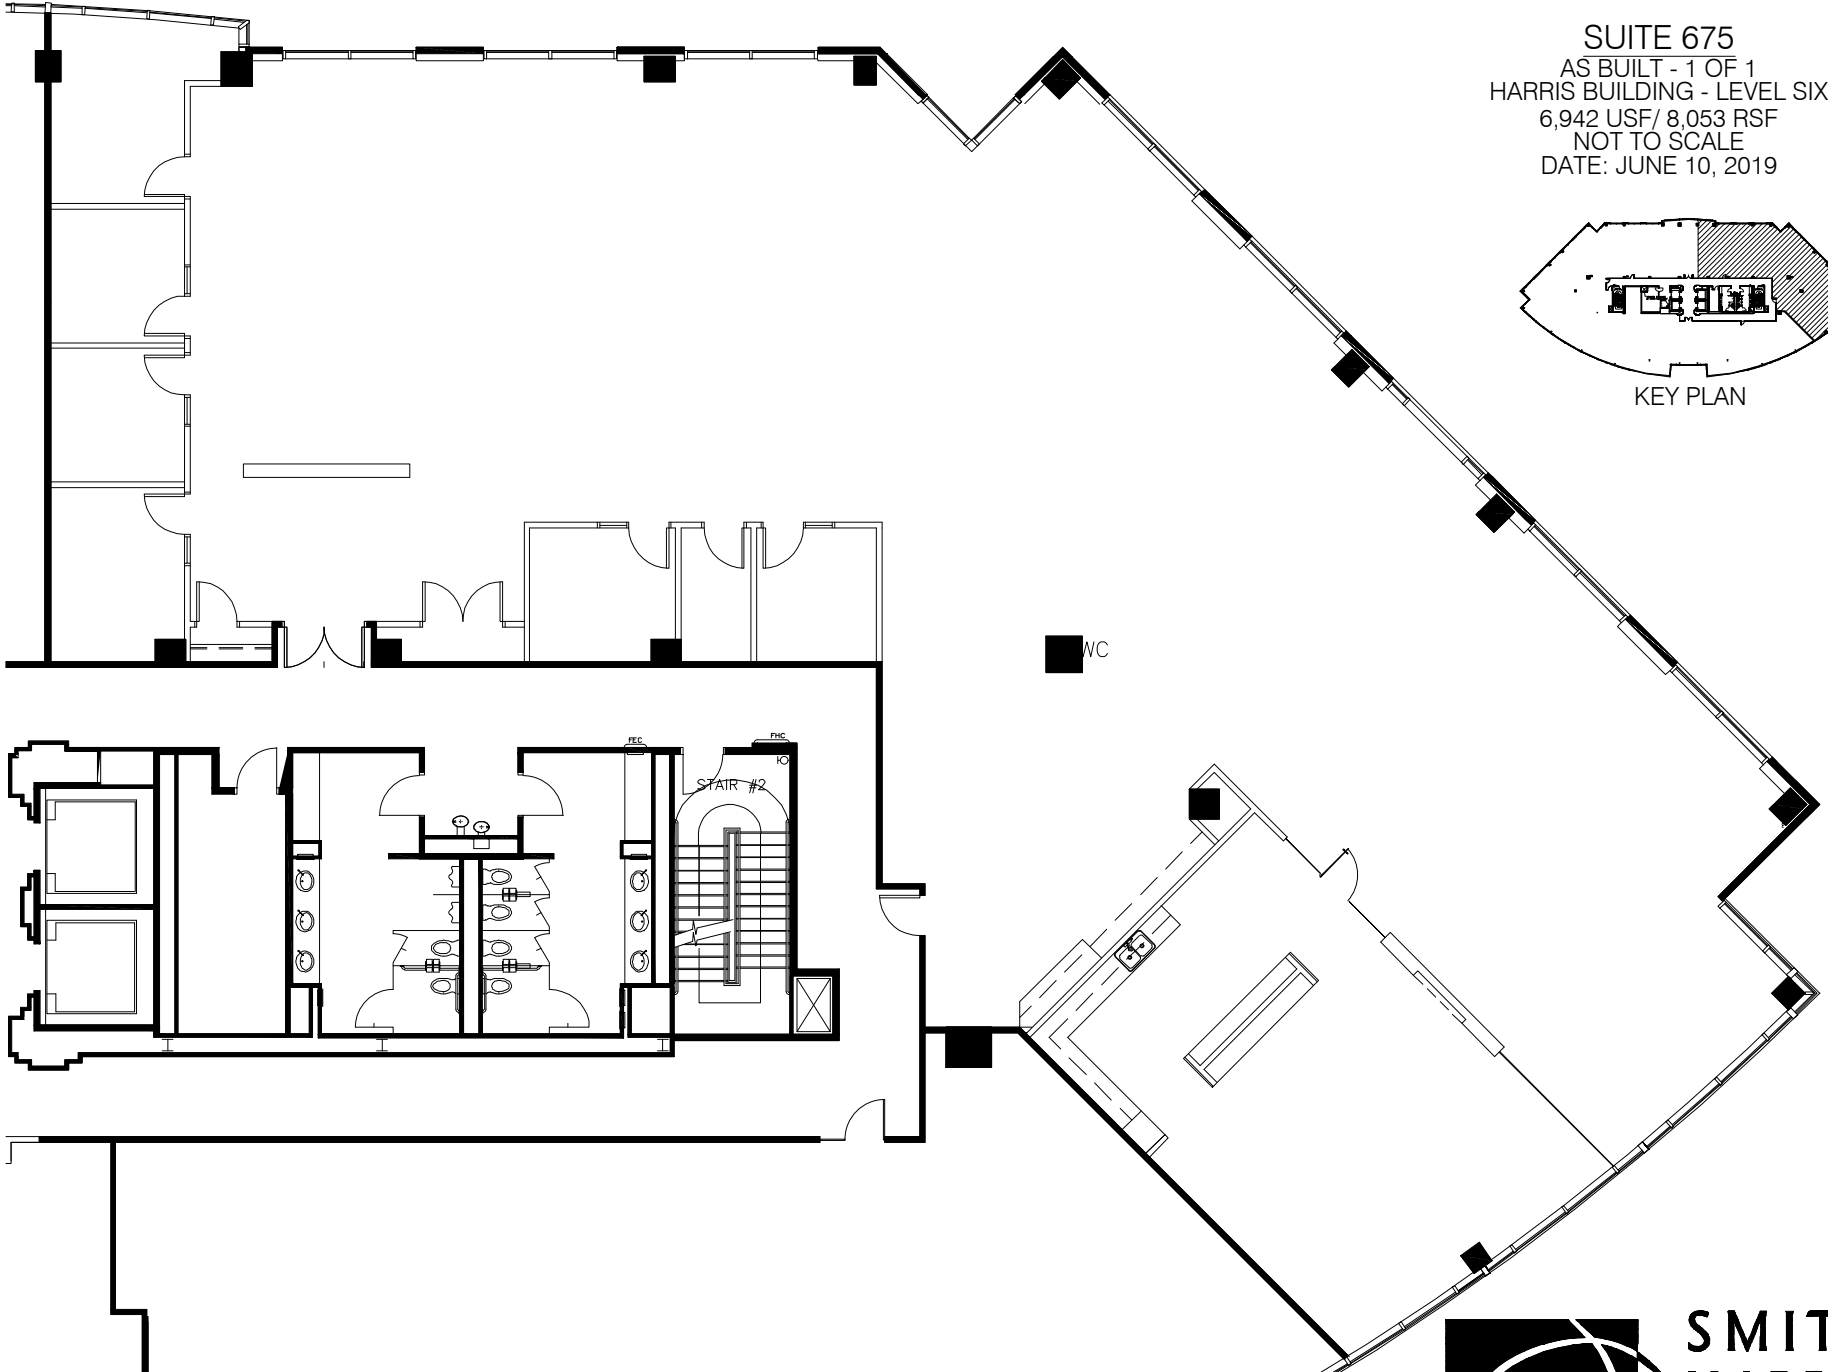

NORTHWOOD
OFFICE

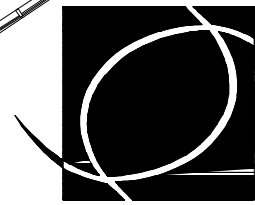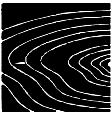

**SMITH
HARRIS
DESIGN**
associates