



SUITE 250
AS BUILT - 1 OF 1
HAYES BUILDING - LEVEL TWO
11,966 USF / 13,881 RSF
NOT TO SCALE
DATE: JULY 12, 2019

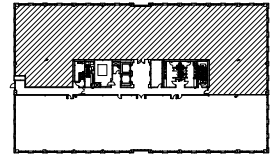

KEY PLAN

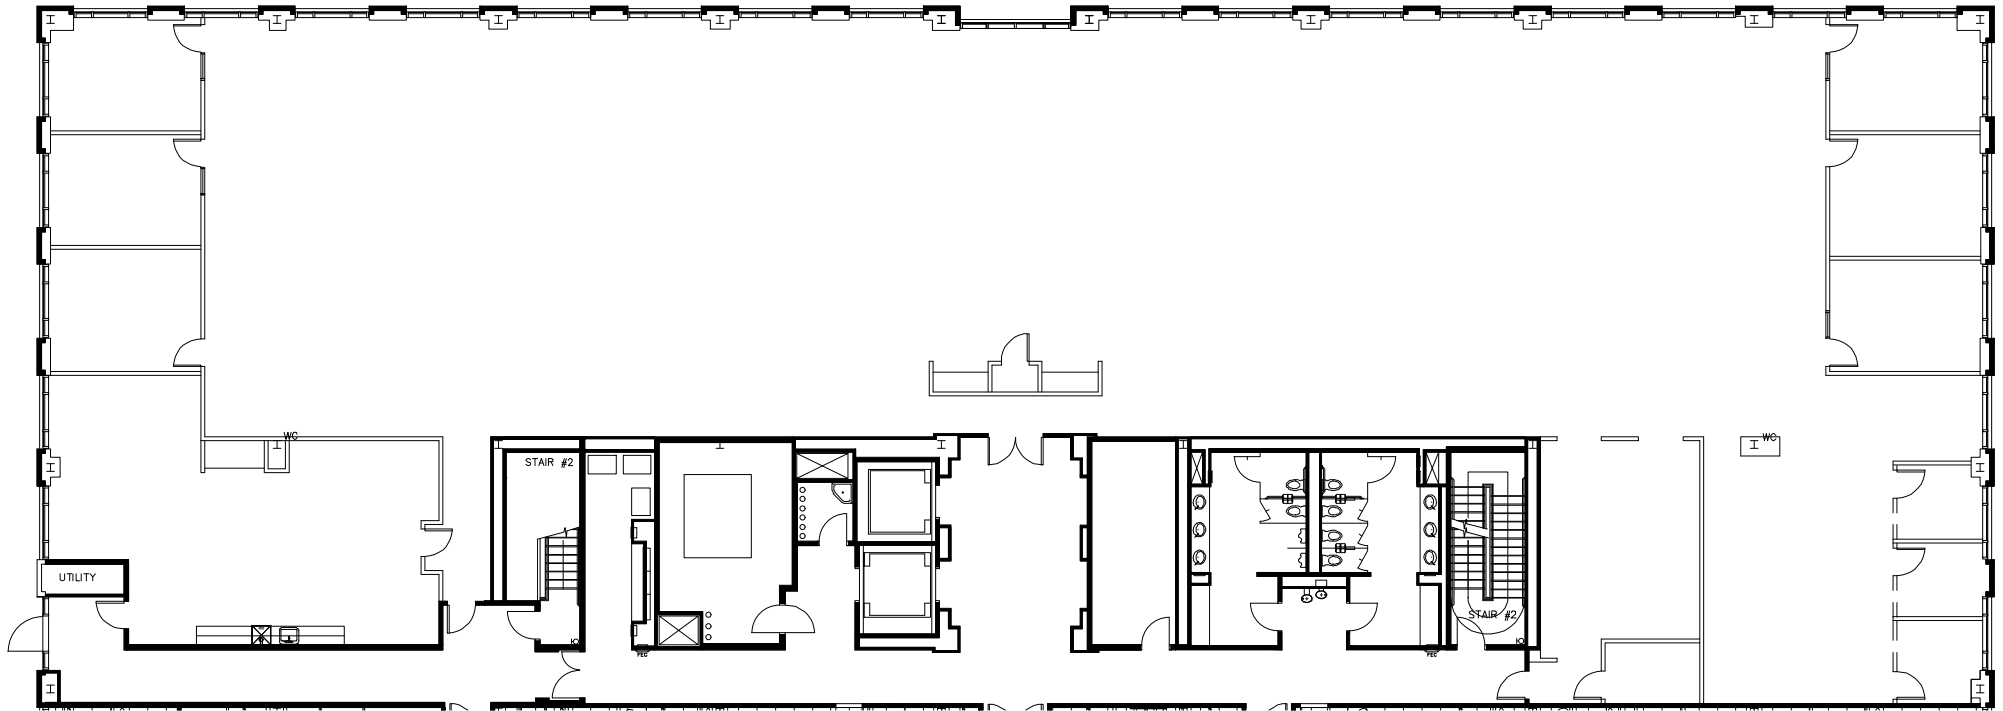

NORTHWOOD
OFFICE



**SMITH
HARRIS
DESIGN**
associates