





SUITE 250  
AS BUILT - 1 OF 1  
HAYES BUILDING - LEVEL TWO  
6,518 USF / 7,561 RSF  
SCALE: 1/16" = 1'-0"  
DATE: AUGUST 17, 2020

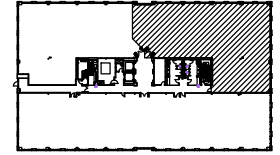

KEY PLAN

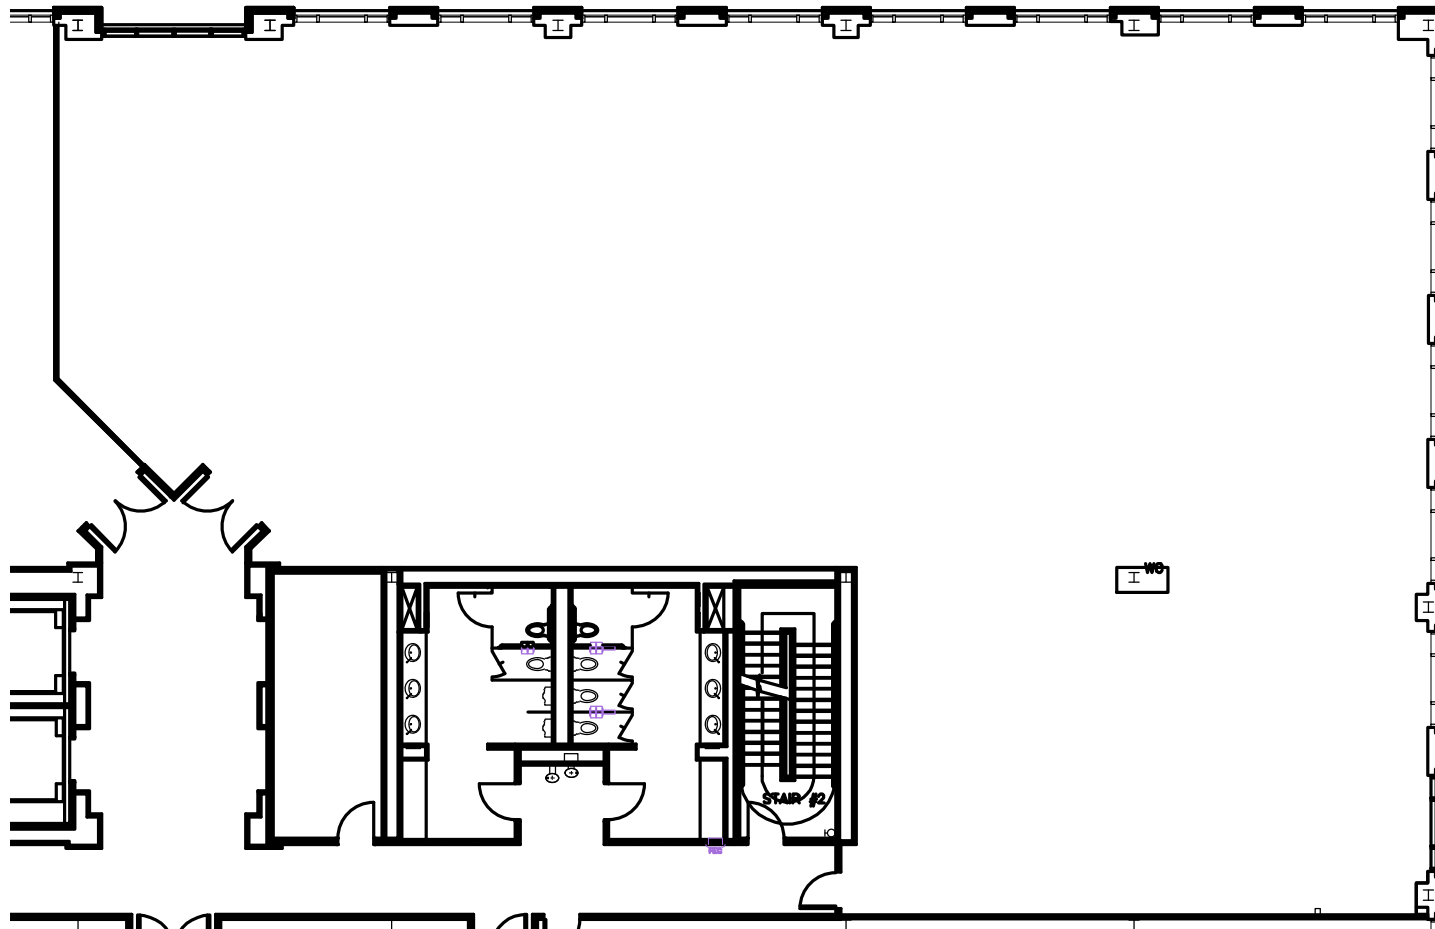

**NORTHWOOD**  
OFFICE

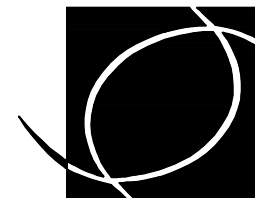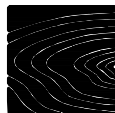

**SMITH  
HARRIS  
DESIGN**  
associates