



SUITE 500
AS BUILT - 1 OF 1
BALLANTYNE ONE - LEVEL FIVE
3,751 USF / 4,351 RSF
SCALE: 3/32" = 1'-0"
DATE: AUGUST 21, 2019

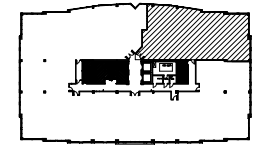

KEY PLAN

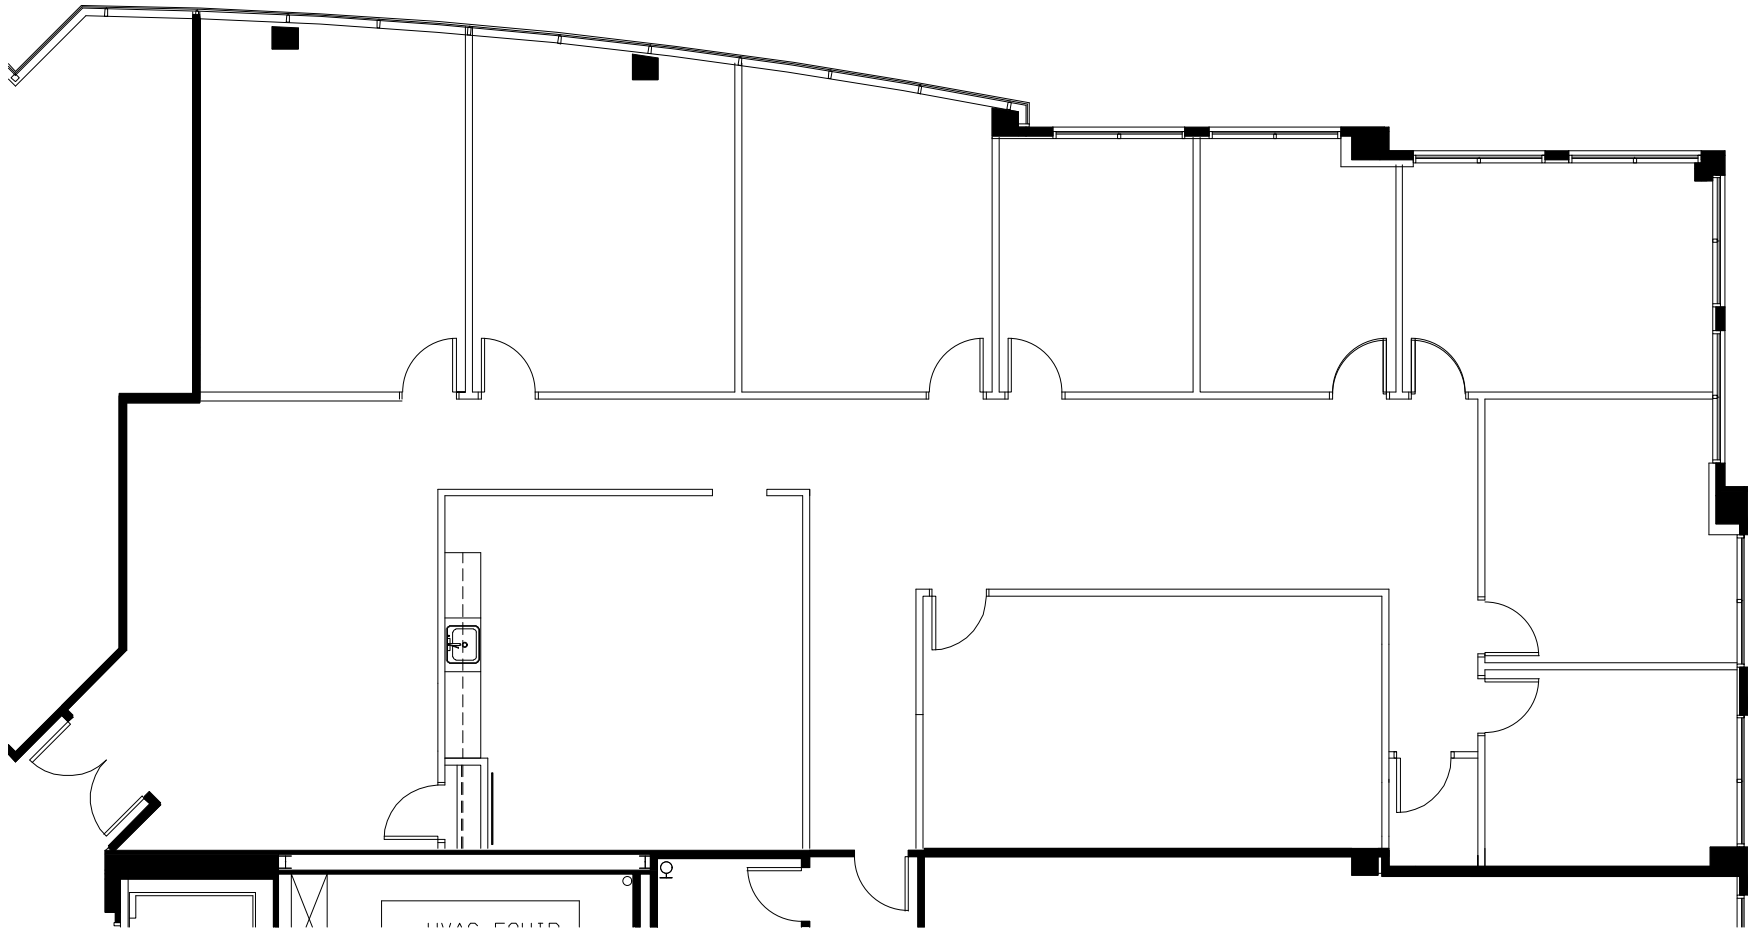

NORTHWOOD
OFFICE



**SMITH
HARRIS**
DESIGN
associates