


# Simmons Building

SUITE 300

24,816 USF / 27,546 RSF

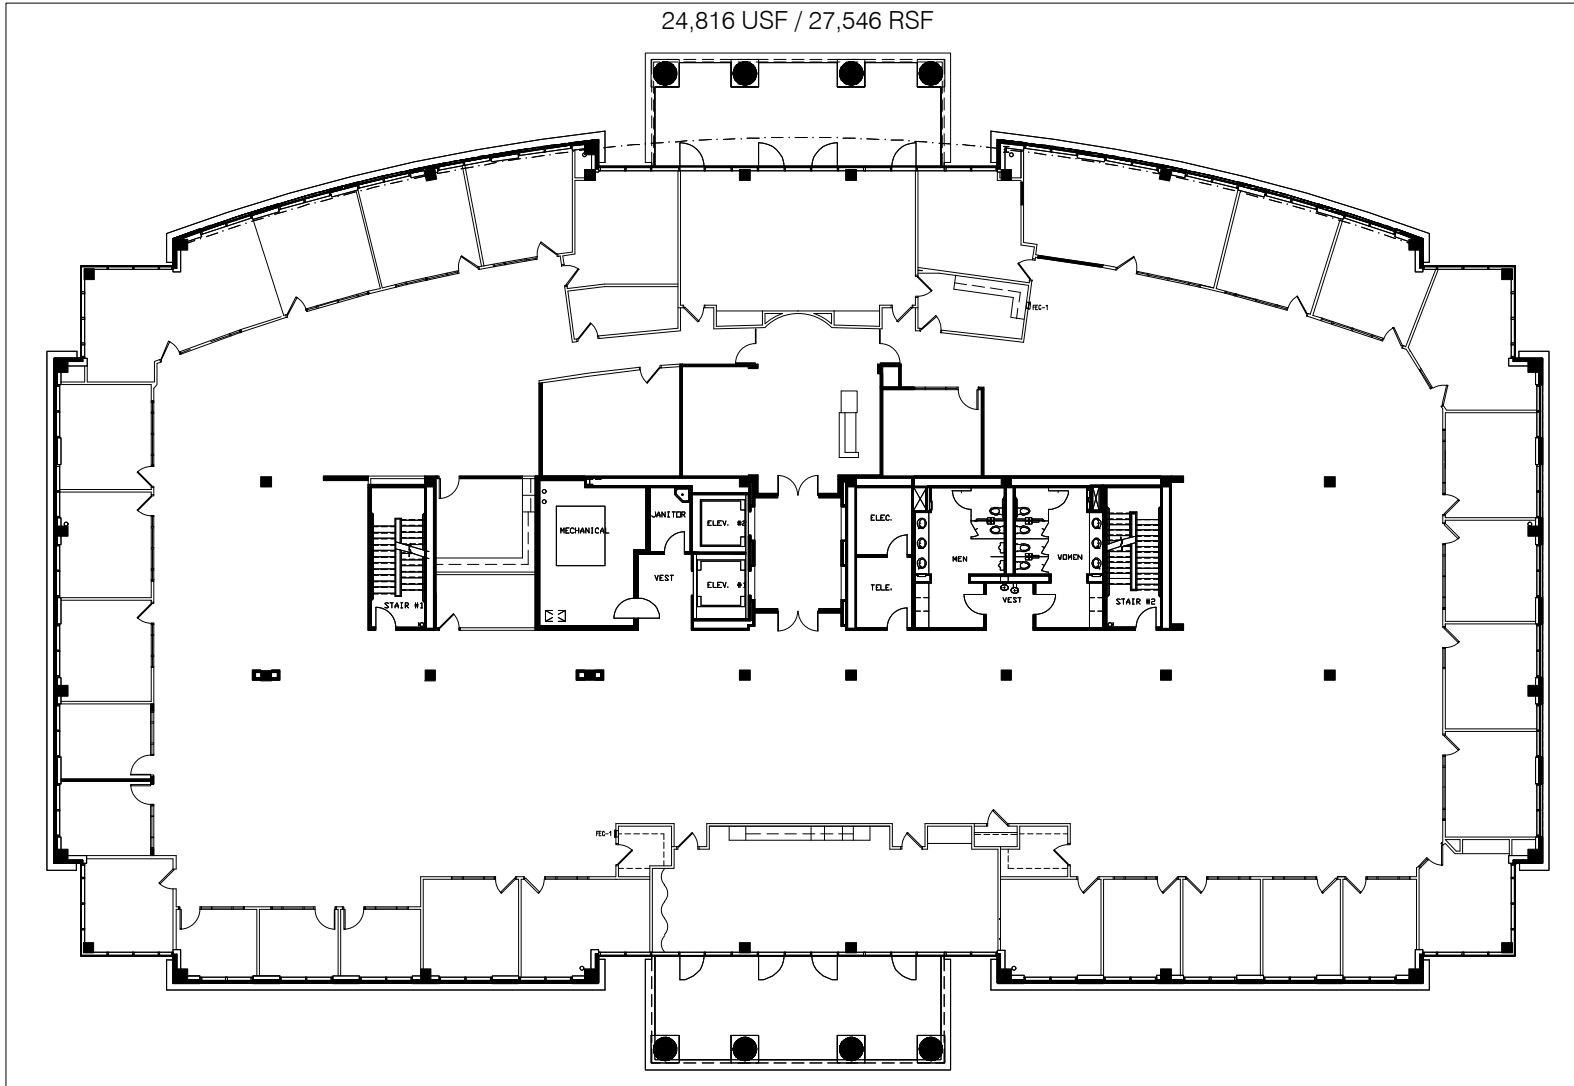

13840 Ballantyne Corporate Place

CBP-1J

Level Three

As Built

December 4, 2019

Not to Scale

**NORTHWOOD**  
OFFICE



**SMITH  
HARRIS**  
DESIGN  
associates