



SUITE 250  
AS BUILT - 1 OF 1  
IRBY BUILDING - LEVEL TWO  
4,310 USF / 5,000 RSF  
SCALE: 3/32" = 1'-0"  
DATE: AUGUST 30, 2019

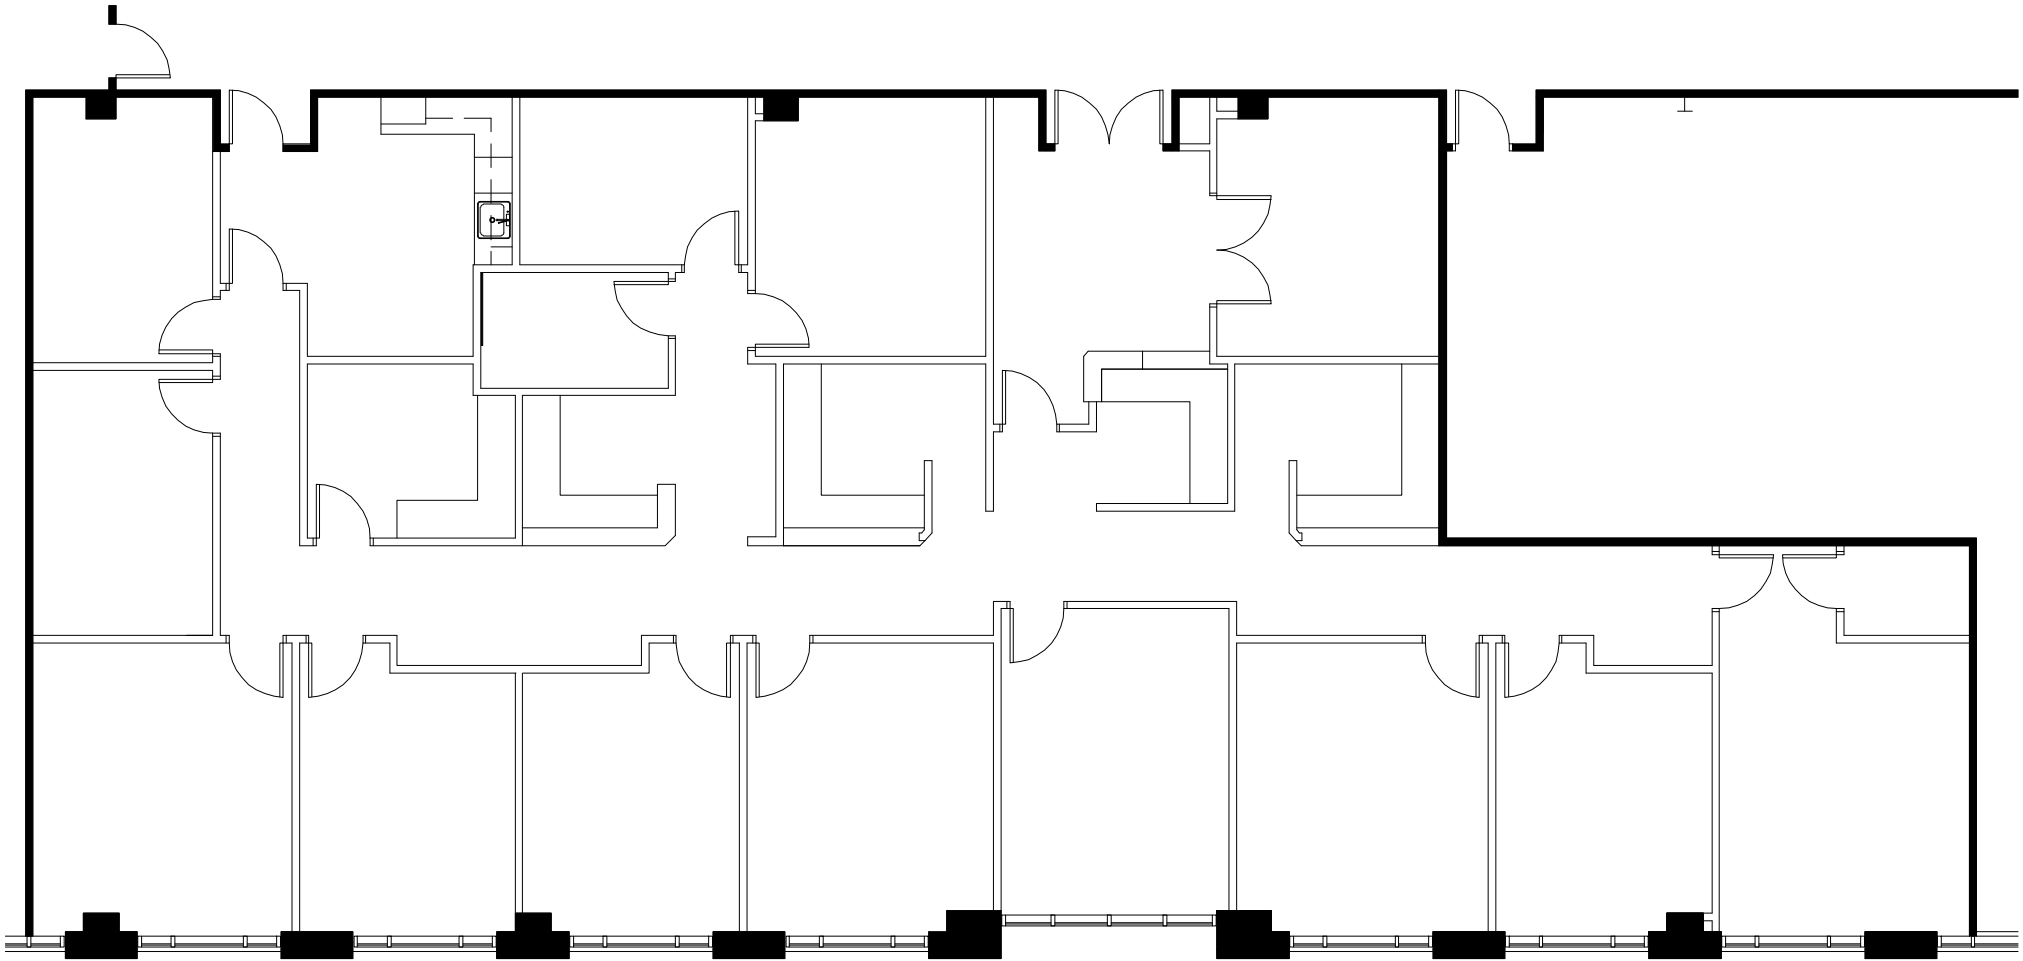

**NORTHWOOD**  
OFFICE

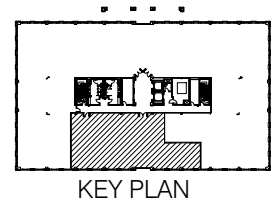

**SMITH  
HARRIS**  
**DESIGN**  
associates