



SUITE 175
AS BUILT - 1 OF 1
FRENETTE BUILDING - LEVEL ONE
2,022 USF/2,346 RSF
SCALE: 1/8" = 1'-0"
DATE: OCTOBER 28, 2019

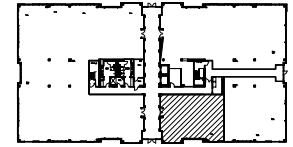

KEY PLAN

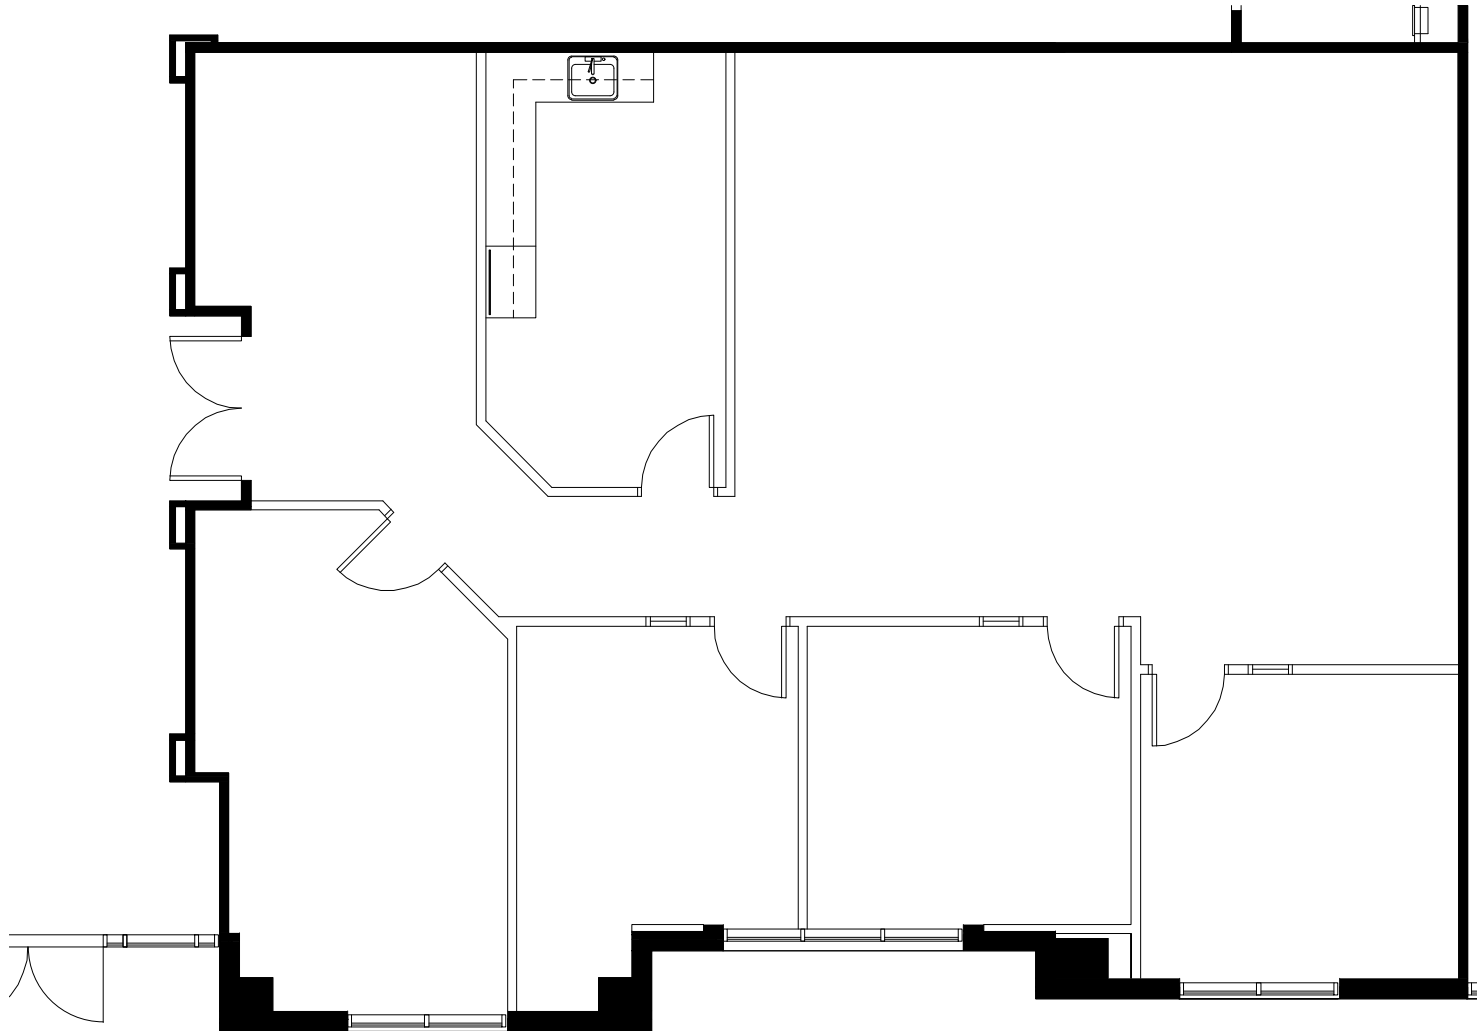

NORTHWOOD
OFFICE



**SMITH
HARRIS**
DESIGN
associates