




SUITE 125  
AS BUILT - 1 OF 1  
CHANDLER BUILDING - LEVEL ONE  
1,360 USF / 1,578 RSF  
SCALE: 1/8" = 1'-0"  
DATE: JANUARY 6, 2020

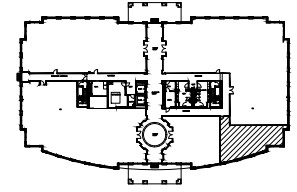

KEY PLAN

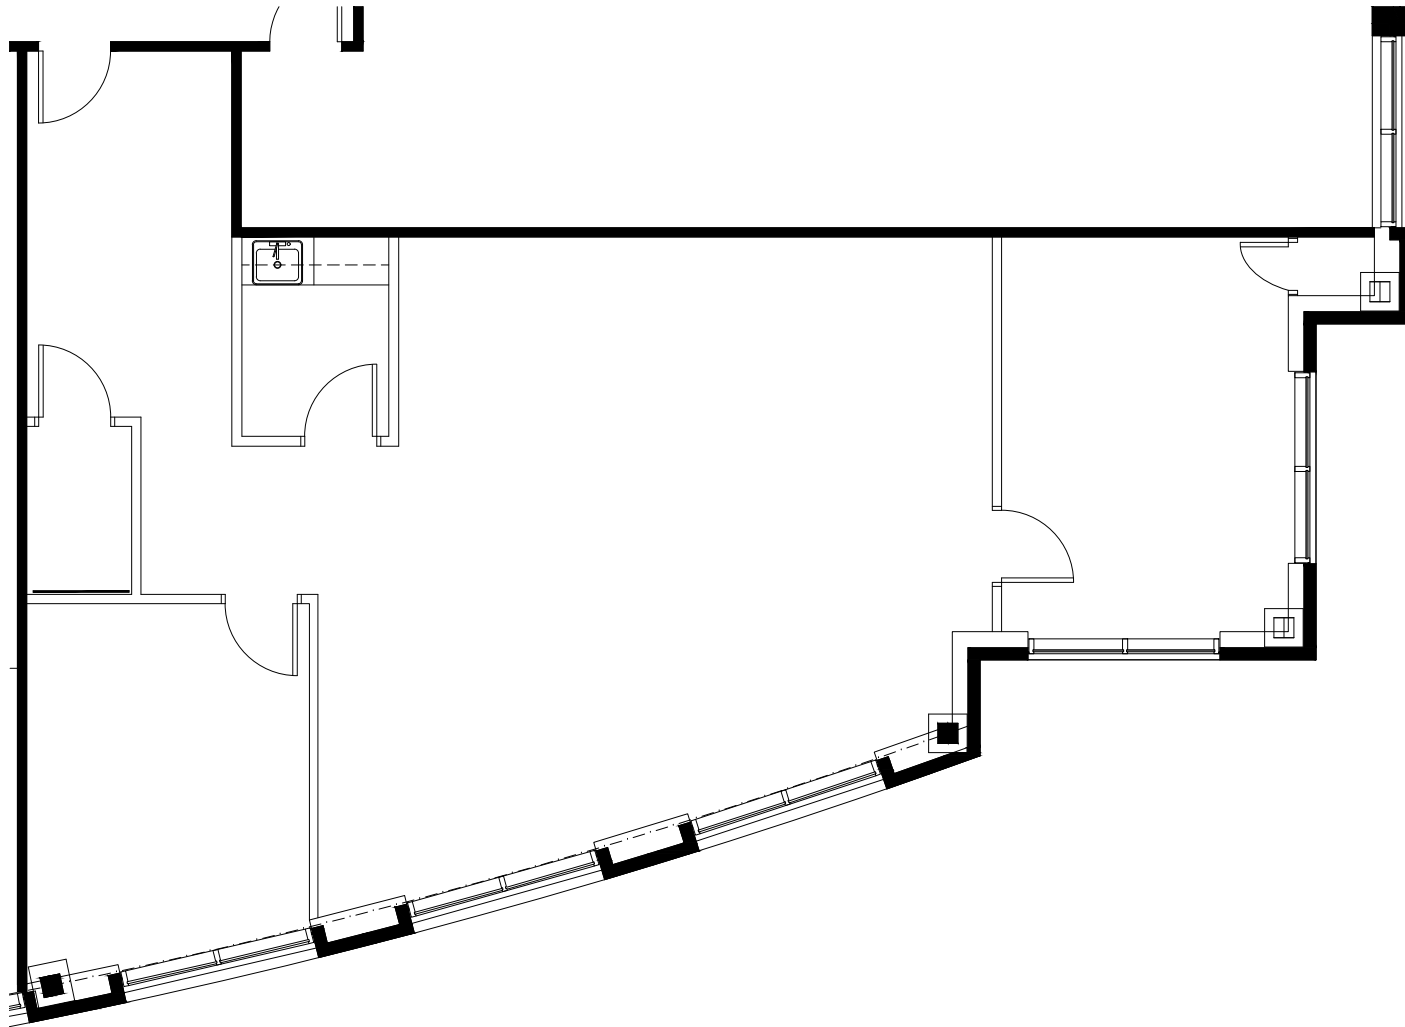

**NORTHWOOD**  
OFFICE

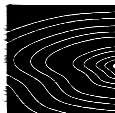

**SMITH  
HARRIS**  
**DESIGN**  
associates