



SUITE 125 & 130
AS BUILT - 1 OF 1
CHANDLER BUILDING - LEVEL ONE
5,752 TOTAL USF / 6,673 TOTAL RSF
SCALE: 1/16" = 1'-0"
DATE: FEBRUARY 11, 2020

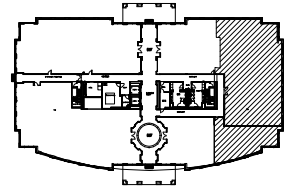

KEY PLAN

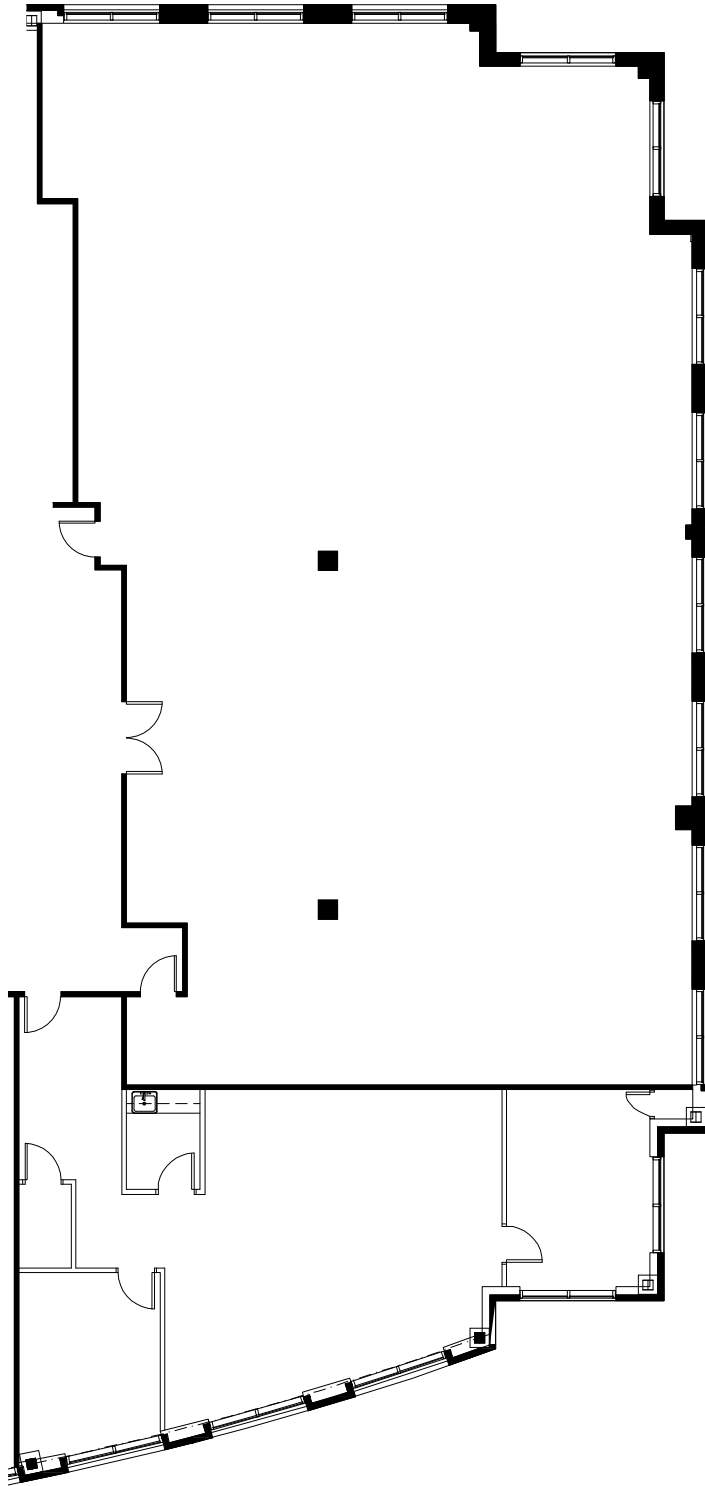

NORTHWOOD
OFFICE



**SMITH
HARRIS**
DESIGN
associates