


AVAILABLE
SUITE 100
37,821 RSF

11115
Rushmore Drive

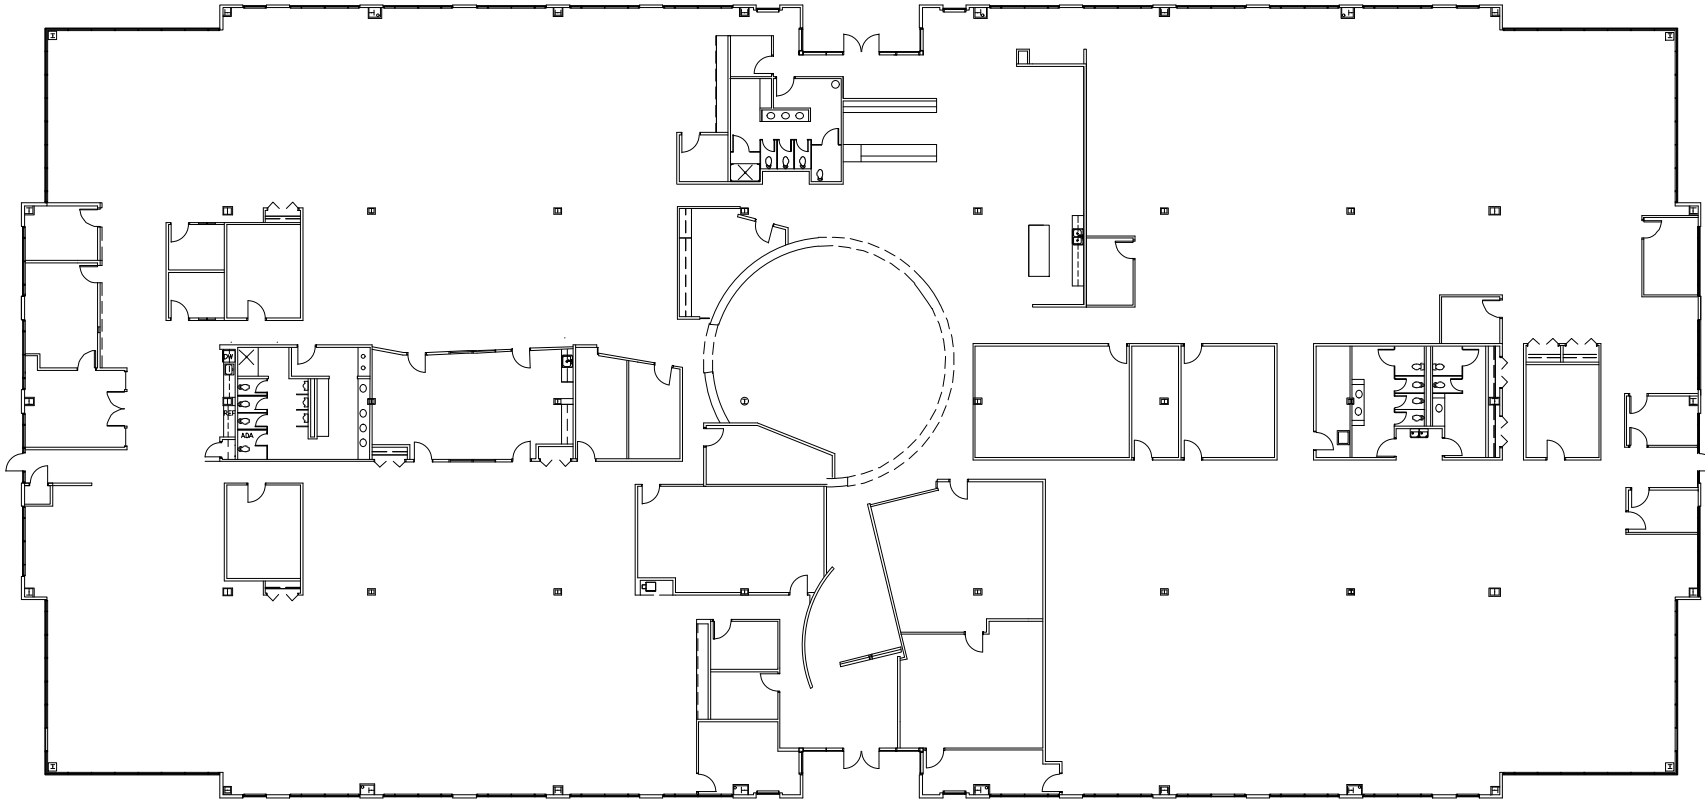

Level
One

As Built

July 8, 2019

Not to Scale

NORTHWOOD
OFFICE



**SMITH
HARRIS**
DESIGN
associates