



SUITE 400
AS BUILT - 1 OF 1
BRIXHAM GREEN ONE - LEVEL FOUR
8,511 USF / 9,873 RSF
SCALE: 1/16" = 1'-0"
DATE: FEBRUARY 21, 2020

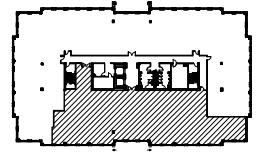

KEY PLAN

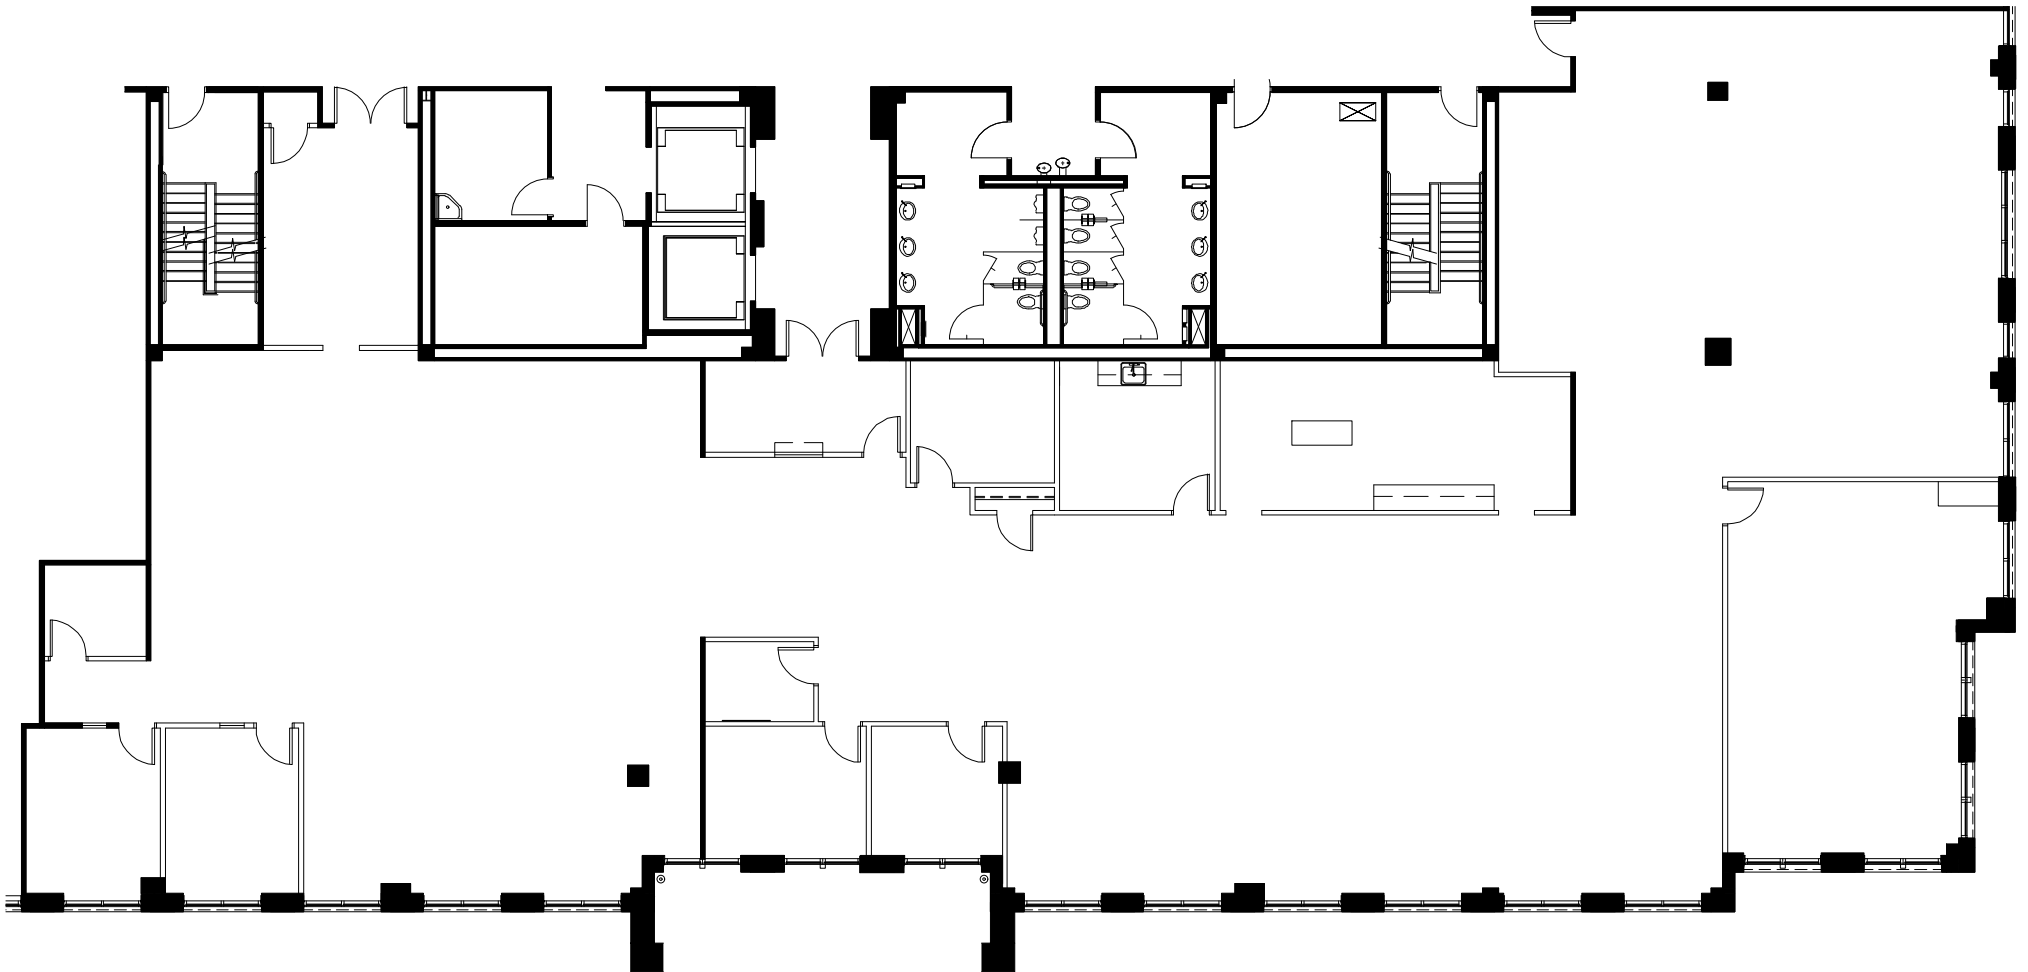

NORTHWOOD
OFFICE



**SMITH
HARRIS**
DESIGN
associates