





SUITE 190
AS BUILT - 1 OF 1
BRIXHAM GREEN III - LEVEL ONE
4,571 TOTAL USF/5,302 TOTAL RSF
NOT TO SCALE
DATE: MARCH 30, 2020

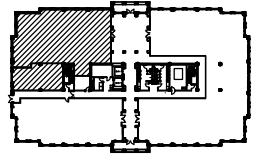

KEY PLAN

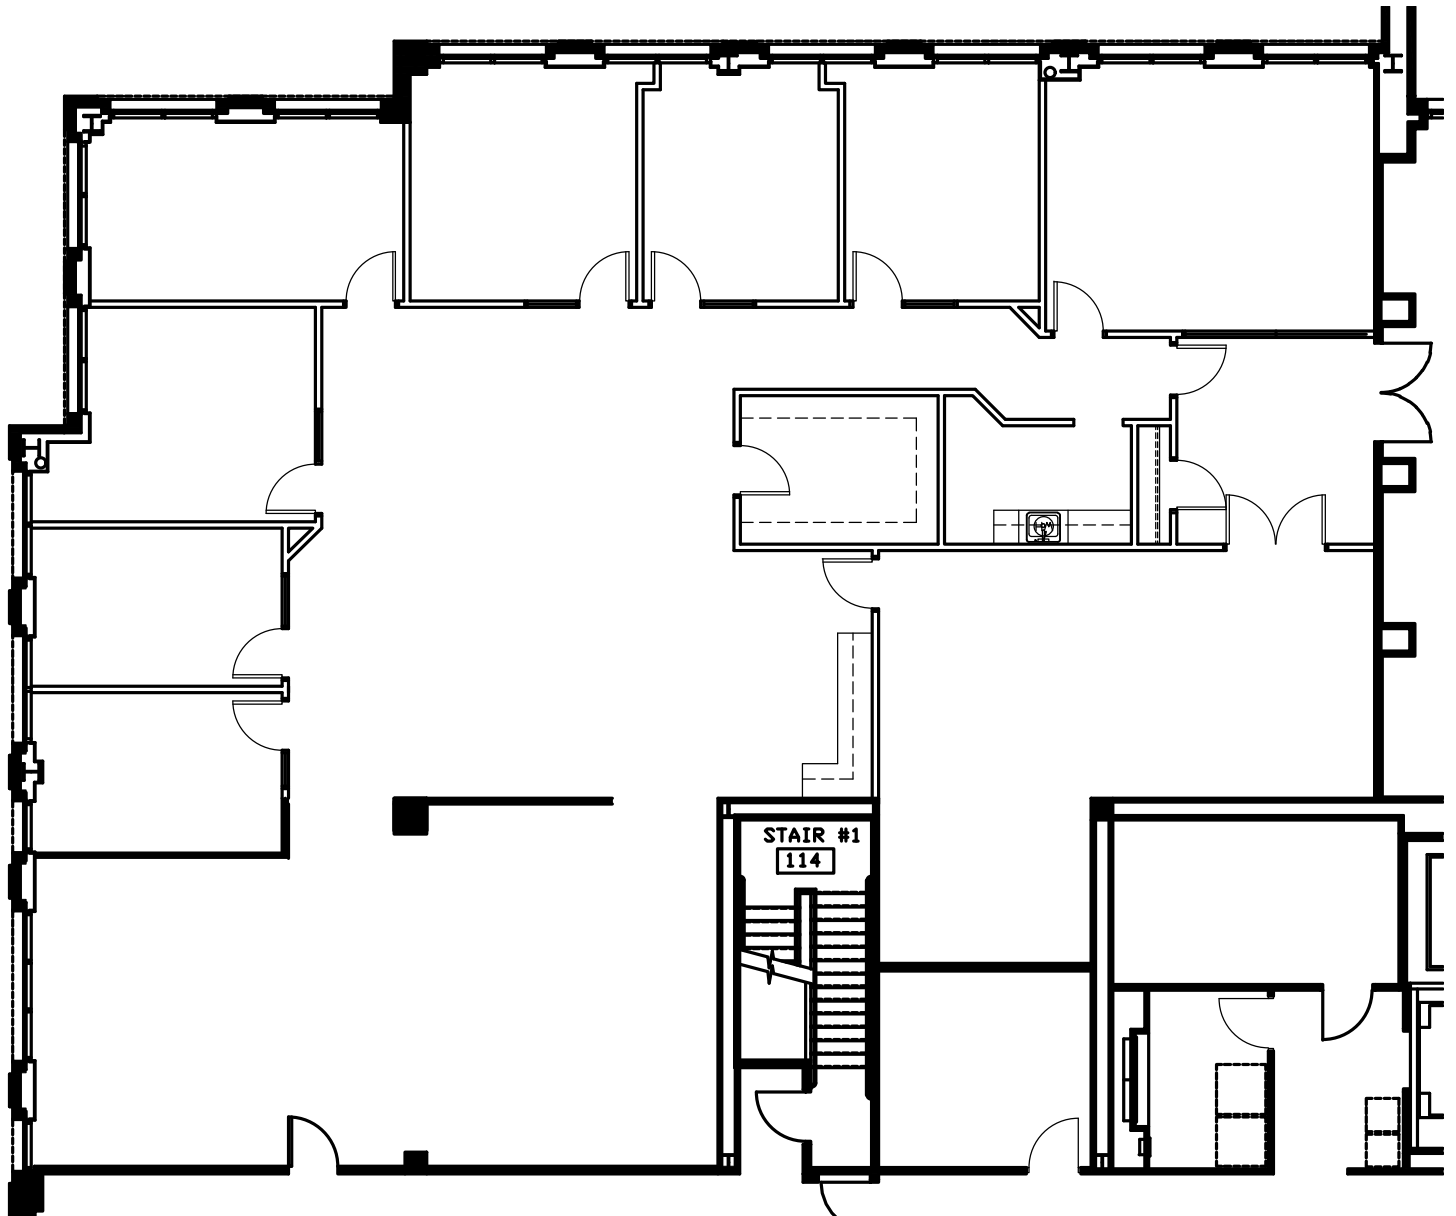

NORTHWOOD
OFFICE

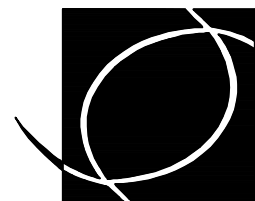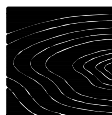

**SMITH
HARRIS**
DESIGN
associates